

SURVEY & REMONUMENTATION

JUN 28 1999

**OTTAWA COUNTY REMONUMENTATION
LAND CORNER RECORDATION CERTIFICATE
Filing Requirement of Act 74, Mich. P.A. 1970**

RECORDED

98 NOV -4 PM 2: 31

For corners in **SECTION**

| (County) | Located In: | Corner Code # |
|------------------------------------|--------------------------|------------------------|
| 1. Public Land Survey | T <u>8N</u> R <u>16W</u> | <u>C-7</u> |
| | T _____ R _____ | <u>(NW-20)</u> |
| | T _____ R _____ | <u>SPRING LAKE TWP</u> |
| | T _____ R _____ | _____ |
| 2. Property Controlling in Section | S _____ T _____ R _____ | _____ |
| | S _____ T _____ R _____ | _____ |
| 3. Miscellaneous Property in Sec. | S _____ T _____ R _____ | _____ |
| | S _____ T _____ R _____ | _____ |

Robert E. Lemke
REGISTER OF DEEDS
OTTAWA COUNTY, MI

Register of Deeds Stamp & File Number

4. Lot No. _____, Recorded Plat _____
5. Private Claims _____

I, Robert E. Lemke, in a field survey on April 14, 1998 do hereby state that under requirements of P.A. 74, Michigan P.A. of 1970, the corner points mentioned in lines 1 and 2 above were in conformance with regulations and rules therefore as required in the current manual of survey instructions of the United States Department of the Interior, Bureau of Land Management or by a decree of a Court of Law and/or that the corner points mentioned in lines 3, 4 and 5 above were in conformance with the rules of the Michigan Board of Land Surveyors or by a Decree of a Court of Law; established, re-established, monumented, recovered, found as expressed below:

| | A | B | C | D | E | F | G | H | I | J | K | L | M |
|----|----|---|----|---|----|---|----|---|----|---|----|---|---|
| 1 | | | | | | | | | | | | | |
| 2 | 6 | | 5 | | 4 | | 3 | | 2 | | 1 | | |
| 3 | | | | | | | | | | | | | |
| 4 | 7 | | 8 | | 9 | | 10 | | 11 | | 12 | | |
| 5 | | | | | | | | | | | | | |
| 6 | 18 | | 17 | | 16 | | 15 | | 14 | | 13 | | |
| 7 | | | | | | | | | | | | | |
| 8 | 19 | | 20 | | 21 | | 22 | | 23 | | 24 | | |
| 9 | | | | | | | | | | | | | |
| 10 | 30 | | 29 | | 28 | | 27 | | 26 | | 25 | | |
| 11 | | | | | | | | | | | | | |
| 12 | 31 | | 32 | | 33 | | 34 | | 35 | | 36 | | |
| 13 | | | | | | | | | | | | | |


NOTE: Not more than 2 corners, all in the same town and range, may be recorded on this certificate.

A. Description of original monument and accessories and/or subsequent restoration:

(see back of page)

B. Description of corner evidence found and/or method applied in restoring or reestablishing corner:

C-7
found cast iron monument
witness's per county survey records 1970
10" Beech S 70° E 31.60' (m = 31.80' found N&T N. side.)
2" iron pipe NW 0.7'
2" iron pipe SE 0.7'
witness's per LCRC (liber 5, page 54)
21" Hemlock W 27.20' (m & rec = 27.20 to Nail)
8" tree S 9.36' (m=9.40') to Nail
5" Maple E 13.24' (m=13.21') to Nail
3" Hemlock N 9.82' (m=9.86') to found Nail & tag
And is accepted as a careful and faithful perpetuation of the position of the original corner.

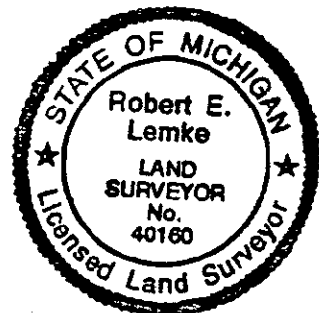

C. Description of monument for corner and accessories established to perpetuate locating the position of the corner:

C-7
Cast iron monument
Found O.C. Remon. Nail & tag S. side of a 24" Hemlock, 4.40' above grade,
Set O.C. Remon. Nail & tag E. side of a 12" Hickory, 1.50' above grade
Found O.C. Remon. Nail & tag N. side of a 6" Maple, 0.6' above grade
Found O.C. Remon. Nail & tag E. side of a 4" Hemlock, 3.6' above grade
2" iron pipe NW 0.7'
2" iron pipe SE 0.7'

10/19/98
S 85° W 27.20'
South 9.38'
N 90° E 13.21'
North 9.83'

APPROVED REMONUMENTATION CORNER
P.A. 34, Mich. P.A. 1970
OTTAWA COUNTY, MI

DATE APPROVED _____

COUNTY REP. _____

Signed by Robert E. Lemke
SDI Consultants, Ltd.
Surveyor's Michigan License No. 40160

Date 4/14/98

\$11.00 FEE
 Receipt # 188
 \$2.00 FEE
 Receipt # 188

SURVEY & REMONUMENTATION

JUN 28 1999

**OTTAWA COUNTY REMONUMENTATION
LAND CORNER RECORDATION CERTIFICATE
Filing Requirement of Act 74, Mich. P.A. 1970**

Page 2

or corners in SECTION

| | | |
|------------------------------------|--------------------------|----------------|
| _____ | Located In: | Corner Code # |
| (County) | | |
| 1. Public Land Survey | T <u>8N</u> R <u>16W</u> | <u>C-7</u> |
| | T _____ R _____ | <u>(NW-20)</u> |
| | T _____ R _____ | _____ |
| | T _____ R _____ | _____ |
| 2. Property Controlling in Section | S _____ T _____ R _____ | _____ |
| | S _____ T _____ R _____ | _____ |
| 3. Miscellaneous Property in Sec. | S _____ T _____ R _____ | _____ |
| | S _____ T _____ R _____ | _____ |

Register of Deeds Stamp & File Number

4. Lot No. _____, Recorded Plat _____
5. Private Claims _____

Robert E. Lemke, in a field survey on April 14, 1998 do hereby state that under requirements of P.A. 74, Michigan P.A. of 1970, the corner points mentioned in lines 1 and 2 above were in conformance with regulations and rules therefore as required in the current manual of survey instructions of the United States Department of the Interior, Bureau of Land Management or by a decree of a Court of Law and /or that the corner points mentioned in lines 3, 4 and 5 above were in conformance with the rules of the Michigan Board of Land Surveyors or by a Decree of a Court of Law; established, re-established, monumented, recovered, found as expressed below:

| | A | B | C | D | E | F | G | H | I | J | K | L | M |
|----|----|---|---|----|---|----|---|----|---|----|---|----|---|
| 1 | | | | | | | | | | | | | |
| 2 | 6 | | | 5 | | 4 | | 3 | | 2 | | 1 | |
| 3 | | | | | | | | | | | | | |
| 4 | 7 | | | 8 | | 9 | | 10 | | 11 | | 12 | |
| 5 | | | | | | | | | | | | | |
| 6 | 18 | | | 17 | | 16 | | 15 | | 14 | | 13 | |
| 7 | | | | | | | | | | | | | |
| 8 | 19 | | | 20 | | 21 | | 22 | | 23 | | 24 | |
| 9 | | | | | | | | | | | | | |
| 10 | 30 | | | 29 | | 28 | | 27 | | 26 | | 25 | |
| 11 | | | | | | | | | | | | | |
| 12 | 31 | | | 32 | | 33 | | 34 | | 35 | | 36 | |
| 13 | | | | | | | | | | | | | |

NOTE: Not more than 2 corners, all in the same town and range, may be recorded on this certificate.

A. Description of original monument and accessories and/or subsequent restoration:
(see back of page)

3. Description of corner evidence found and/or method applied in restoring or reestablishing corner:

C-7
found cast iron monument
witness's per county survey records 1970
10" Beech S 70° E 31.60' (m = 31.80' found N&T N. side.)
2" iron pipe NW 0.7'
2" iron pipe SE 0.7'
witness's per LCRC (liber 5, page 54)
21" Hemlock W 27.20' (m & rec = 27.20 to Nail)
8" tree S 9.36' (m = 9.40') to Nail
5" Maple E 13.24' (m = 13.21') to Nail
3" Hemlock N 9.82' (m = 9.86') to found Nail & tag
And is accepted as a careful and faithful perpetuation of the position of the original corner.

C. Description of monument for corner and accessories established to perpetuate locating the position of the corner:

C-7
Cast iron monument
Found O.C. Remon. Nail & tag S. side of a 24" Hemlock, 4.40' above grade, S 85° W 27.20'
Set O.C. Remon. Nail & tag E. side of a 12" Hickory, 1.50' above grade South 9.38'
Found O.C. Remon. Nail & tag N. side of a 6" Maple, 0.6' above grade N 90° E 13.21'
Found O.C. Remon. Nail & tag E. side of a 4" Hemlock, 3.6' above grade North 9.83'
2" iron pipe NW 0.7'
2" iron pipe SE 0.7'

APPROVED REMONUMENTATION CORNER
P.A. 345 OF 1990
OTTAWA COUNTY

DATE APPROVED _____

COUNTY REP. _____

Signed by _____

Date _____

SDI Consultants, Ltd.

Surveyor's Michigan License No. _____