

DEC 01 1998

**OTTAWA COUNTY REMONUMENTATION
SECTION LAND CORNER RECORDATION CERTIFICATE
Filing Requirement of Act 74, Mich. P.A. 1970**

For corners in

<u>Ottawa</u> <small>(County)</small>	Located In:	Corner Code #
1. Public Land Survey	T <u>8</u> N R <u>16</u> W	C-8
	T _____ R _____	_____
	T _____ R _____	_____
	T _____ R _____	_____
2. Property Controlling in Section	S _____ T _____ R _____	West 1/4 corner
	S _____ T _____ R _____	Section 20
3. Miscellaneous Property in Sec.	S _____ T _____ R _____	Spring Lake Twp
	S _____ T _____ R _____	_____

RECORDED
98 JUL 24 PM 1:45

Darryl S. Hill
REGISTER OF DEEDS
OTTAWA COUNTY, MI

Register of Deeds Stamp & File Number

4. Lot No. _____, Recorded Plat _____
5. Private Claims _____

1	A	B	C	D	E	F	G	H	I	J	K	L	M
2	6	5	4	3	2	1							
3													
4	7	8	9	10	11	12							
5													
6	18	17	16	15	14	13							
7													
8	19	20	21	22	23	24							
9													
10	30	29	28	27	26	25							
11													
12	31	32	33	34	35	36							
13													

I, Steve Lampen, in a field survey on May 19 98, do hereby certify that under requirements of P.A. 74, Michigan P.A. of 1970, the corner points mentioned in lines 1 and 2 above were in conformance with regulations and rules therefore as required in the current manual of survey instructions of the United States Department of the Interior, Bureau of Land Management or by a decree of a Court of Law and/or that the corner points mentioned in lines 3, 4 and 5 above were in conformance with the rules of the Michigan Board of Land Surveyors or by a Decree of a Court of Law; established, re-established, monumented, re-monumented, recovered, found as expressed below:

NOTE: Not more than 4 corners, all in the same town and range, may be recorded on this certificate.

A. Description of original monument and accessories and/or subsequent restoration:

C-8
GLO - Mullett - 1837
South between Sections 19 and 20
40.00 set quarter section post
Pine 6 N 1 E. 1.86
Aspin 6 S 1 E. 1.35

C-8 is shown on survey in:
L2 surveys P 832 - Clapp
L2 surveys P 352 - Clapp

C-6 is shown on Plats of
North Shore Grand Haven Plat - 1946
Amended North Shore Grand Haven Plat - 1988

PA. 345 OTTAWA COUNTY

FIELD APPROVED 6-15-98

S.D.W.

B. Description of corner evidence found and/or method applied in restoring or reestablishing corner:

C-8

Found concrete monument. Position of the concrete monument agrees with the amended Plat but seems to be 2 ft. South of position per North Shore Grand Haven Plat by reference to the found concrete monuments North and South. Found concrete monument was of the same type and did not appear to be recently disturbed. Used concrete monument as found.

Found concrete monument is accepted as a careful and faithful perpetuation of the position of the original corner.


C. Description of monument for corner and accessories established to perpetuate locating the position of the corner:

C-8

Concrete Monument

Azimuth = Michigan State Plane Grid Direction

Remonumentation tag in South side	8" Pine	77° 50'	21.37
Remonumentation tag in West side	6" Pine	4° 39'	24.03
Remonumentation tag in NW side	6" Pine	231° 05'	13.43
Concrete monument		181° 13'	252.38
Concrete monument		1° 08'	97.91

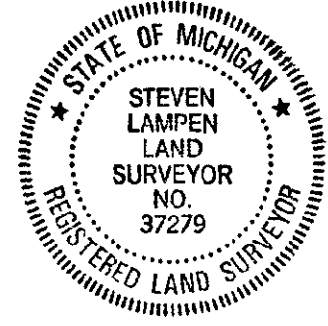

Signed by Steven Lampen
Surveyor's Michigan License No. 37279

Date JULY 20, 1998

FORM APPROVED BY MICHIGAN STATE BOARD OF LAND SURVEYORS, JAN. 1971

REVISED MAY 1975
REVISED MAY 1983
ADAPTED FOR WORD PROCESSING 1983

\$9.06
RECEIVED
JUL 23 1998