

SURVEY & REMONUMENTATION

APR 25 1995

COMMISSION

OTTAWA COUNTY REMONUMENTATION LAND CORNER RECORDATION CERTIFICATE

Filing Requirement of Act 74, Mich. P.A. 1970

PAGE I

SEE PAGE II

For corners in

Ottawa

(County)

Located In:

Corner Code:##

- | | | |
|---------------------------------------|--------------------------|-----------------------------|
| 1. Public Land Survey | T <u>8N</u> R <u>16W</u> | D-1, N $\frac{1}{2}$ corner |
| | T _____ R _____ | Section 5 |
| | T _____ R _____ | Spring Lake Twp |
| | T _____ R _____ | _____ |
| 2. Property Controlling | S _____ T _____ R _____ | _____ |
| In Section | S _____ T _____ R _____ | _____ |
| 3. Miscellaneous | S _____ T _____ R _____ | _____ |
| Property in Sec. | S _____ T _____ R _____ | _____ |
| 4. Lot No. _____, Recorded Plat _____ | | |
| 5. Private Claims _____ | | |

RECORDED

96 DEC -8 PM 12:29

Polycelia Robinson
REGISTER OF DEEDS
OTTAWA COUNTY, MI

Register of Deeds Stamp & File Number

I, THOMAS E. JOINER in a field survey on 10-13- 19 94, do hereby certify that under requirements of P.A. 74, Michigan P.A. of 1970, the corner points mentioned in lines 1 and 2 above were in conformance with regulations and rules therefore as required in the current manual of survey instructions of the United States Department of the Interior, Bureau of Land Management or by a decree of a Court of Law and/or that the corner points mentioned in lines 3, 4 and 5 above were in conformance with the rules of the Michigan Board of Land Surveyors or by a Decree of a Court of Law; established, re-established, monumented, re-monumented, recovered, found as expressed below:

	A	B	C	D	E	F	G	H	I	J	K	L	M
2	6	5	4	3	2								
3													
4	7	8	9	10	11	12							
5													
6	18	17	16	15	14	13							
7													
8	19	20	21	22	23	24							
9													
10	30	29	28	27	26	25							
11													
12	31	32	33	34	35	36							
13													

NOTE: Not more than 4 corners, all in the same town and range, may be recorded on this certificate.

A. Description of original monument and accessories and/or subsequent restoration:

05-06-1837 Post set by John Mullet, D.S. N 4° W 3 6" Tamarack S 69° E 6 6" Tamarack	Liber 3, Pg. 292, 09-18-78 Set Cast Iron Monument NW 55.09 8" Twin Cherry NE 62.23 Support Pole SE 37.97 4" White Birch SW 45.26 Power Pole	Liber 1, Pg. 51, 06-29-71 Found iron pipe SW 45.15 Nail in face of power pole SE 38.64 Nail in face of 4" Pine SE 37.92 Nail in face of 4" Birch NW 85.49 Nail in face of 8" Twin Birch NE 62.19 Nail in face of guy pole NE 55.52 C _L Street Sign
--	--	--

3. Description of corner evidence found and/or method applied in restoring or reestablishing corner:

Found Cast Iron Monument and accepted as a careful and faithful perpetuation of the position of the original corner.

Liber 3, Pg. 292, 09-18-78 NW 55.09 8" Twin Cherry NE 62.23 Support Pole SE 37.97 4" White Birch SW 45.26 Power Pole	Liber 1, Pg. 51, 06-29-71 SW 45.15 Nail in Power Pole SE 38.64 Nail in 4" Pine SE 37.92 Nail in 4" Birch NW 85.49 Nail in 8" Twin Birch NE 62.19 Nail in Guy Pole NE 55.52 C _L Street Sign	Liber 1, Pg. 11, 05-10-71 SW 45.15 Nail in Power Pole SE 38.64 Nail in 4" Pine SE 37.92 Nail in 4" Birch NW 85.49 Nail in 8" Twin Birch NE 62.19 Nail in Guy Pole NE 55.52 C _L Street Sign
--	---	---

C. Description of monument for corner and accessories established to perpetuate locating the position of the corner:

Cast Iron Monument

O.C. Remon. Tag & Nail in W side Guy Pole	Az. 23°	62.56
O.C. Remon. Tag & Nail in SW side 8" White Birch	Az. 122°	38.21
O.C. Remon. Tag & Nail in SW side Twin 10" Cherry	Az. 303°	55.79
O.C. Remon. Tag & Nail in SW side Twin 12" Birch	Az. 323°	85.33
S edge of asphalt of Wilson Road	Az. 0°	3.82


PA. 345 OTTAWA COUNTY

PEER APPROVED 11/21/94

Signed by Thomas E. Joiner

Date 11-21-94

Surveyor's Michigan License No. 18435

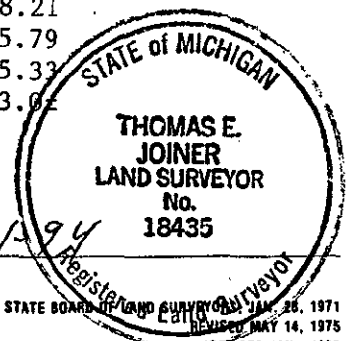

OTTAWA COUNTY REMONUMENTATION
LAND CORNER RECORDATION CERTIFICATE
 Filing Requirement of Act 74, Mich. P.A. 1970

For corners in

Ottawa
(County)

Located In:

Corner Code ##

- | | | |
|------------------------------------|--------------------------|--|
| 1. Public Land Survey | T <u>8N</u> R <u>16W</u> | <u>D-1, N$\frac{1}{2}$ corner</u> |
| | T ___ R ___ | <u>Section 5</u> |
| | T ___ R ___ | <u>Spring Lake Twp</u> |
| | T ___ R ___ | _____ |
| 2. Property Controlling in Section | S ___ T ___ R ___ | _____ |
| | S ___ T ___ R ___ | _____ |
| 3. Miscellaneous Property in Sec. | S ___ T ___ R ___ | _____ |
| | S ___ T ___ R ___ | _____ |

Register of Deeds Stamp & File Number

4. Lot No. _____, Recorded Plat _____
 5. Private Claims _____

	A	B	C	D	E	F	G	H	I	J	K	L	M
2	6		5		4		3		2		1		
3													
4	7		8		9		10		11		12		
5													
6	18		17		16		15		14		13		
7													
8	19		20		21		22		23		24		
9													
10	30		29		28		27		26		25		
11													
12	31		32		33		34		35		36		
13													

I, THOMAS E. JOINER, in a field survey on 10-13- 19 94, do hereby certify that under requirements of P.A. 74, Michigan P.A. of 1970, the corner points mentioned in lines 1 and 2 above were in conformance with regulations and rules therefore as required in the current manual of survey instructions of the United States Department of the Interior, Bureau of Land Management or by a decree of a Court of Law and/or that the corner points mentioned in lines 3, 4 and 5 above were in conformance with the rules of the Michigan Board of Land Surveyors or by a Decree of a Court of Law; established, re-established, monumented, re-monumented, recovered, found as expressed below:

NOTE: Not more than 4 corners, all in the same town and range, may be recorded on this certificate.

A. Description of original monument and accessories and/or subsequent restoration:


- Liber 1, Pg. 11, 05-10-71
- Found Iron Pipe
- SW 45.15 Nail in Power Pole
- SE 38.64 Nail in 4" Pine
- SE 37.92 Nail in 4" Birch
- NW 85.49 Nail in 8" Twin birch
- NE 62.19 Nail in Guy Pole
- NE 55.52 C_L Street Sign

B. Description of corner evidence found and/or method applied in restoring or reestablishing corner:

C. Description of monument for corner and accessories established to perpetuate locating the position of the corner:

PA. 345 OTTAWA COUNTY
 PEER APPROVED 11/21/94

Handwritten signature: Rodney P. Newbold

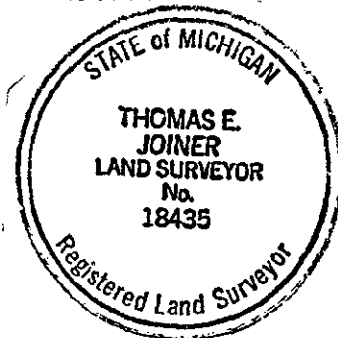

Signed by Thomas E. Joiner Date 11-21-94
 Surveyor's Michigan License No. 18435