

**SURVEY &
REMONUMENTATION**

APR 25 1995

OTTAWA COUNTY REMONUMENTATION
LAND CORNER RECORDATION CERTIFICATE
Filing Requirement of Act 74, Mich. P.A. 1970

RECORDED

94 DEC -8 PM 12: 28

COMMISSION


For corners in
OTTAWA

Phyllis Holman
REGISTER OF DEEDS
OTTAWA COUNTY, MI

(County)	Located In:	Corner Code #
1. Public Land Survey	T <u>8N</u> R <u>16W</u>	D-3, S $\frac{1}{2}$ Corner
	T _____ R _____	Section 5
	T _____ R _____	Spring Lake Twp.
	T _____ R _____	
2. Property Controlling in Section	S _____ T _____ R _____	
	S _____ T _____ R _____	
3. Miscellaneous Property in Sec.	S _____ T _____ R _____	
	S _____ T _____ R _____	

Register of Deeds Stamp & File Number

4. Lot No. _____, Recorded Plat _____
5. Private Claims _____

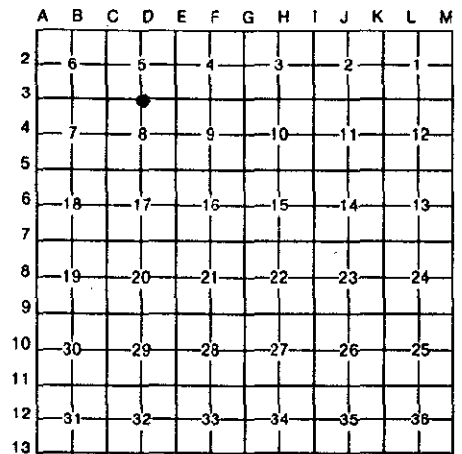

I, THOMAS E. JOINER, in a field survey on 10-13- 1994, do hereby certify that under requirements of P.A. 74, Michigan P.A. of 1970, the corner points mentioned in lines 1 and 2 above were in conformance with regulations and rules therefore as required in the current manual of survey instructions of the United States Department of the Interior, Bureau of Land Management or by a decree of a Court of Law and/or that the corner points mentioned in lines 3, 4 and 5 above were in conformance with the rules of the Michigan Board of Land Surveyors or by a Decree of a Court of Law; established, re-established, monumented, re-monumented, recovered, found as expressed below:

NOTE: Not more than 4 corners, all in the same town and range, may be recorded on this certificate.

A. Description of original monument and accessories and/or subsequent restoration:

04-03-1837	Liber 5, Pg. 53, 05-17-83	Liber 1, Pg. 235, 01-11-72
Post set by John Mullet, D.S.	Set Cast Iron Monument	Found Iron Pipe, Raised w/ ang. iron
South 70 10" Tamarack	SE 53.54 Power Pole	S45°E 53.11 Nail in face Power Pole
	WSW 26.28 Light Pole	SE 60.40 Nail in face 9" Ced. Post
	NE 49.57 ϵ Hydrant	S70°W 26.29 Light Pole
	NW 49.45 Steel Gate Post	

B. Description of corner evidence found and/or method applied in restoring or reestablishing corner:


Found broken off Cast Iron Monument in Monument Box and accepted as a careful and faithful perpetuation of the position of the original corner.

Liber 5, Pg. 53, 05-17-83	Liber 1, Pg. 235, 01-11-72
WSW 26.28 Light Pole	S 45° E 53.11 Nail in Face of Power Pole
NE 49.57 ϵ Hydrant	S 70° W 26.29 Light Pole
SE 53.54 ϵ Power Pole	

C. Description of monument for corner and accessories established to perpetuate locating the position of the corner:

Broken off Cast Iron Monument in Monument Box

C _L Top operating Nut on Fire Hydrant	Az. 64°	49.65
O.C. Remon. Tag & Nail in SW side 8" Maple	Az. 136°	80.08
O.C. Remon. Tag & Nail in S side Light Pole	Az. 253°	26.58
O.C. Remon. Tag & Nail in SW side 14" Poplar	Az. 307°	75.58

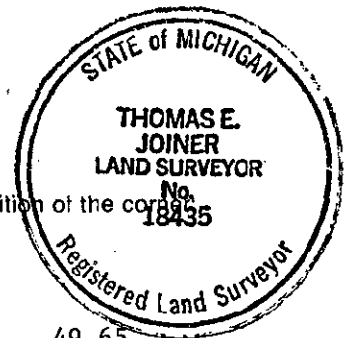

Signed by Thomas E. Joiner Date 11-21-94
Peer Approved 11/21/94

Surveyor's Michigan License No. 18435