

SURVEY & REMONUMENTATION

JUN 28 1999

**OTTAWA COUNTY REMONUMENTATION
LAND CORNER RECORDATION CERTIFICATE
Filing Requirement of Act 74, Mich. P.A. 1970**

RECORDED

98 NOV -4 PM 2: 31

SECTION

For corners in

(County)	Located In:	Corner Code #
1. Public Land Survey	T. <u>8N</u> R. <u>16W</u>	<u>D-9</u>
	T. _____ R. _____	<u>N 1/4 29</u>
	T. _____ R. _____	<u>GRAND HAVEN TWP</u>
	T. _____ R. _____	_____
2. Property Controlling in Section	S. _____ T. _____ R. _____	_____
	S. _____ T. _____ R. _____	_____
3. Miscellaneous Property in Sec.	S. _____ T. _____ R. _____	_____
	S. _____ T. _____ R. _____	_____

Sam [Signature]
REGISTER OF DEEDS
OTTAWA COUNTY, MI

Register of Deeds Stamp & File Number

4. Lot No. _____, Recorded Plat _____
5. Private Claims _____

I, Robert E. Lemke, in a field survey on May 7, 1998 do hereby state that under requirements of P.A. 74, Michigan P.A. of 1970, the corner points mentioned in lines 1 and 2 above were in conformance with regulations and rules therefore as required in the current manual of survey instructions of the United States Department of the Interior, Bureau of Land Management or by a decree of a Court of Law and /or that the corner points mentioned in lines 3, 4 and 5 above were in conformance with the rules of the Michigan Board of Land Surveyors or by a Decree of a Court of Law; established, re-established, monumented, recovered, found as expressed below:

	A	B	C	D	E	F	G	H	I	J	K	L	M
1													
2	6		5		4		3		2		1		
3													
4	7		8		9		10		11		12		
5													
6	18		17		16		15		14		13		
7													
8	19		20		21		22		23		24		
9													
10	30		29		28		27		26		25		
11													
12	31		32		33		34		35		36		
13													

NOTE: Not more than 2 corners, all in the same town and range, may be recorded on this certificate.

A. Description of original monument and accessories and/or subsequent restoration:
(see back of page)


B. Description of corner evidence found and/or method applied in restoring or reestablishing corner:

Found cast iron monument
witness's per LCRC (liber 2, page 149)
North line of house to East, South 5.6'
8" Beech East 33.04' (m=32.30') to Nail
And is accepted as a careful and faithful perpetuation of the position of the original corner.

10/19/98
RDJ

C. Description of monument for corner and accessories established to perpetuate locating the position of the corner:

Cast iron monument
O.C. nail & tag, 0.2 above grade in a 6" Ash N 20° W 32.47'
O.C. nail & tag, 1.0' above grade in the SW side of a 28" Maple N 55° E 40.22'
O.C. nail & tag, 4.6' above grade in the NE side of a 12" triple Cherry S 10° E 50.75'
O.C. nail & tag, 0.3' above grade in the SE side of an 8" Cherry S 60° W 4.48'

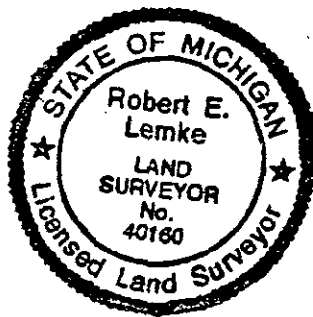

APPROVED REMONUMENTATION CORNER
P.A. 74, Mich. P.A. 1970
OTTAWA COUNTY

DATE APPROVED _____
COUNTY REP. _____

Signed by Robert E. Lemke
SDI Consultants, Ltd.
Surveyor's Michigan License No. 40160

Date 5/7/98

A. Description of original monument and accessories and/or subsequent restoration: D-9 continued;

SURVEY &
REMONUMENTATION

JUN 28 1999

SECTION

D-9
GLO
West between sections 20 and 29
40.0 chains
Set 1/2 mile post
Beech 8" S 53° E 20 lks
Beech 10" N 44° W 20 lks

D-9 is shown on Plat of "Leggat's Addition to the City of Grand Haven"
J.C. Brayton C.E. 1873

County survey notes
E.H. Peck July 28, 1903
Section 20 T8N, R16W
N. 726 ft and E 33 ft. Set gas pipe is NW Lot 15
N 39° E 51.5 ft to S. cor. House

LCRC May 07, 1973
John P. Clapp Liber 2, Pg 149
Found iron pipe
N. line Hse. To E. South 5.6'
8" Beech East 33.04'
18" Beech NE 96.32'

Cast iron monument (No recorded LCRC with these witnesses found)
O.C. nail & tag, 0.2' above grade in a 6" Ash N 20° W 32.47'
O.C. nail & tag, 1.0' above grade in the SW side of a 28" Maple N 55° E 40.22'
O.C. nail & tag, 4.6' above grade in the NE side of a 12" triple Cherry S 10° E 50.75'
O.C. nail & tag, 0.3' above grade in the SE side of an 8" Cherry S 60° W 4.48'