

RECORDED

OTTAWA COUNTY REMONUMENTATION  
LAND CORNER RECORDATION CERTIFICATE  
Filing Requirement of Act 74, Mich. P.A. 1970

96 DEC 18 PM 4:55  
*Richard A. Carlstrom*  
REGISTER OF DEEDS  
OTTAWA COUNTY, MI

For corners in

Ottawa (County)	Located In:	Corner Code ##
1. Public Land Survey	T 8N R 16W	D-11, S 1/2 corner Section 29 Spring Lake Twp
	T R	
	T R	
	T R	
2. Property Controlling in Section	S T R	
	S T R	
3. Miscellaneous Property in Sec.	S T R	
	S T R	
4. Lot No. _____, Recorded Plat _____		
5. Private Claims _____		

Register of Deeds Stamp & File Number

I, Thomas E. Joiner, in a field survey on September 17, 19 96, do hereby certify that under requirements of P.A. 74, Michigan P.A. of 1970, the corner points mentioned in lines 1 and 2 above were in conformance with regulations and rules therefore as required in the current manual of survey instructions of the United States Department of the Interior, Bureau of Land Management or by a decree of a Court of Law and/or that the corner points mentioned in lines 3, 4 and 5 above were in conformance with the rules of the Michigan Board of Land Surveyors or by a Decree of a Court of Law; established, re-established, monumented, re-monumented, recovered, found as expressed below:

NOTE: Not more than 4 corners, all in the same town and range, may be recorded on this certificate.


	A	B	C	D	E	F	G	H	I	J	K	L	M
2	6		5		4		3		2		1		
3													
4	7		8		9		10		11		12		
5													
6	18		17		16		15		14		13		
7													
8	19		20		21		22		23		24		
9													
10	30		29		28		27		26		25		
11													
12	31		32		33		34		35		36		
13													

IIA. Description of original monument and accessories and/or subsequent restoration:

Gov't. Notes Page 265  
John Mullett, D.S.  
Between March 26 - April 6, 1837  
Set 1/2 Mile Post 40.00 chains  
West of Southeast Section Corner  
29-8-16. No witnesses were given.

P.A. 345 OTTAWA COUNTY  
PEER APPROVED 12-9-96

*T. E. Joiner*

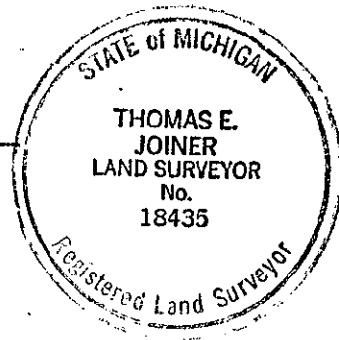

B. Description of corner evidence found and/or method applied in restoring or reestablishing corner:

D-11  
Found 1" Steel Shaft And Accepted As A Careful And Faithful Perpetuation Of The Original Corner. Set 3' Long Steel Bar With Ottawa County Remon. Cap.

D-11 is also described as being the Northwest corner of "Bottje Subdivision" as recorded in Liber 10 of Plats, Page 63.

See detail on reverse side.

D-11 is also described as being part of Scheifele Ridge Subdivision as recorded in Liber 24 on Pages 56 - 57.

1" steel shaft was checked by dimensions within the Bottje Subdivision and Joiner Engineering, Inc. Job #9563.

C. Description of monument for corner and accessories established to perpetuate locating the position of the corner:

D-11 Set 3' Long Steel Bar With Ottawa Co. Remon. Cap			
Ottawa County Remon tag and nail in S Side 30" Oak	AZ 80°	Dist.	68.40
Southwest Corner Of 2 Story Brick House #205 Valley Ct.	AZ 27°	Dist.	32.57
Ottawa County Remon tag and nail in W Side 10" Beech	AZ 188°	Dist.	16.22
Ottawa County Remon tag and nail in NW Side 26" Oak	AZ 225°	Dist.	44.38'

Signed by Thomas E. Joiner Date 12-6-96  
Surveyor's Michigan License No. 18435

SE. COR.  
SEC. 29 T 8 N R 16 W

D - II S 1/4 COR.  
SEC. 29 T 8 N R 16 W  
NW. COR. "BOTTJE SUB."  
LIBER 10, PAGE 63

ROBBINS ROAD

M = 2648.14'

