

**SURVEY &
REMONUMENTATION**

APR 25 1995

COMMISSION

OTTAWA COUNTY REMONUMENTATION
LAND CORNER RECORDATION CERTIFICATE
Filing Requirement of Act 74, Mich. P.A. 1970

For corners in

PAGE I

SEE PAGE II

Ottawa (County)	Located In:	Corner Code #
1. Public Land Survey	T <u>8N</u> R <u>16W</u>	<u>E-1, NW corner</u>
	T _____ R _____	<u>Section 4</u>
	T _____ R _____	<u>Spring Lake Twp</u>
	T _____ R _____	_____
2. Property Controlling in Section	S _____ T _____ R _____	_____
	S _____ T _____ R _____	_____
3. Miscellaneous Property in Sec.	S _____ T _____ R _____	_____
	S _____ T _____ R _____	_____
4. Lot No. _____, Recorded Plat _____		
5. Private Claims _____		

RECORDED

01. DEC -8 PM 12: 29

Registered Land Surveyor
REGISTER OF DEEDS
OTTAWA COUNTY, MI

Register of Deeds Stamp & File Number

I, THOMAS E. JOINER in a field survey on 10-13-, 19 94, do hereby certify that under requirements of P.A. 74, Michigan P.A. of 1970, the corner points mentioned in lines 1 and 2 above were in conformance with regulations and rules therefore as required in the current manual of survey instructions of the United States Department of the Interior, Bureau of Land Management or by a decree of a Court of Law and/or that the corner points mentioned in lines 3, 4 and 5 above were in conformance with the rules of the Michigan Board of Land Surveyors or by a Decree of a Court of Law; established, re-established, monumented, re-monumented, recovered, found as expressed below:

NOTE: Not more than 4 corners, all in the same town and range, may be recorded on this certificate.

	A	B	C	D	E	F	G	H	I	J	K	L	M
2	6	5	4	3	2	1							
3													
4	7	8	9	10	11	12							
5													
6	18	17	16	15	14	13							
7													
8	19	20	21	22	23	24							
9													
10	30	29	28	27	26	25							
11													
12	31	32	33	34	35	36							
13													


A. Description of original monument and accessories and/or subsequent restoration:

05-06-1837	Liber 5, Pg. 51, 05-17-83	Liber 1, Pg. 283, 02-15-72
Post set by John Mullet, D.S.	Set Cast Iron Monument	Found Steel Rod
N 49° E 29 14" White Ash	N 35.00 Telephone Pole	SE 69.48 NW Corn. House #805
N 61° W 21 18" Pine	South 22.21 Power Pole	SW 51.14 NE Corner Pump House
	SW 54.63 SE Cor. Well Pit	S 21.70 Nail in face of Power Pole
	SE 45.50 12" Maple	NW 72.88 Nail in face of 6" Spruce

B. Description of corner evidence found and/or method applied in restoring or reestablishing corner:

Found Broken off Cast Iron Monument in Monument Box and accepted as a careful and faithful perpetuation of the original corner.

Liber 5, Pg. 51, 05-17-83	Liber 1 Pg. 53, 06-26-71
North 35.00 Telephone Pole	SSE 32.70 Nail in face of 6" Cedar
South 22.21 Power Pole	
SE 45.50 12" Maple	Liber 1, Pg. 283, 02-15-72
	SE 69.48 NW corner House #805
	South 21.70 Nail in Power Pole
	NW 72.88 Nail in 6" Spruce

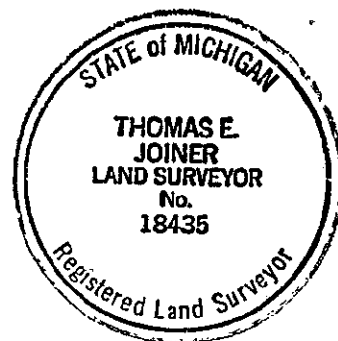

C. Description of monument for corner and accessories established to perpetuate locating the position of the corner:

Broken off Cast Iron Monument in Monument Box

NW corner conc. foundation House #805	Az. 153°	69.53
O.C. Remon Tag & Nail in W side 10" Cedar	Az. 173°	32.98
NE Corn. Bottom Conc. Step, 0.6' above ground House #787	Az. 220°	46.83
O.C. Remon. Tag & Nail in NE side 18" White Pine	Az. 331°	51.79

PA. 345 OTTAWA COUNTY

PEER APPROVED 11/21/94

Signed by Thomas E. Joiner

Date 11-21-94

Surveyor's Michigan License No. 18435

1 of 2

OTTAWA COUNTY REMONUMENTATION
LAND CORNER RECORDATION CERTIFICATE
 Filing Requirement of Act 74, Mich. P.A. 1970

PAGE II

or corners in

Ottawa <small>(County)</small>	Located In:	Corner Code #	
Public Land Survey	T <u>8N</u> R <u>16W</u>	E-1, NW Corner	
	T _____ R _____	Section 4	
	T _____ R _____	Spring Lake Twp	
	T _____ R _____		
Property Controlling in Section	S _____ T _____ R _____		
Miscellaneous	S _____ T _____ R _____		
Property in Sec.	S _____ T _____ R _____		

Register of Deeds Stamp & File Number

Lot No. _____, Recorded Plat _____
 Private Claims _____

	A	B	C	D	E	F	G	H	I	J	K	L	M
2	6	5	4	3	2	1							
3													
4	7	8	9	10	11	12							
5													
6	18	17	16	15	14	13							
7													
8	19	20	21	22	23	24							
9													
10	30	29	28	27	26	25							
11													
12	31	32	33	34	35	36							
13													

THOMAS E. JOINER, in a field survey on 10-13- 19 99,
 do hereby certify that under requirements of P.A. 74, Michigan P.A. of 1970, the corner points mentioned in lines 1 and 2 above were in conformance with regulations and rules therefore as required in the current manual of survey instructions of the United States Department of the Interior, Bureau of Land Management or by a decree of a Court of Law and/or that the corner points mentioned in lines 3, 4 and 5 above were in conformance with the rules of the Michigan Board of Land Surveyors or by a Decree of a Court of Law; established, re-established, monumented, re-monumented, recovered, found as expressed below:

NOTE: Not more than 4 corners, all in the same town and range, may be recorded on this certificate.

Description of original monument and accessories and/or subsequent restoration:

Liber 1, Pg. 53, 07-29-71
 Found $\frac{1}{2}$ " Steel Bar
 NNW 34.94 Nail in face of Telephone Pole
 SE 45.15 Nail in face of 5" Maple
 SSW 21.69 Nail in face of Power Pole
 SSE 32.70 Nail in face of 6" Cedar
 SW 46.03 Nail in face of 12" Pine


Liber 1, Pg. 9, 0504-71
 Found Steel Bar
 NNW 34.94 Nail in Telephone Pole
 SE 45.15 Nail in 5" Maple
 SSW 21.69 Nail in Power Pole
 SSE 32.70 Nail in 6" Cedar
 SW 46.03 Nail in 12" Pine

Description of corner evidence found and/or method applied in restoring or reestablishing corner:

Description of monument for corner and accessories established to perpetuate locating the position of the corner:

PA. 345 OTTAWA COUNTY
 PEER APPROVED 11/21/94

Handwritten Signature

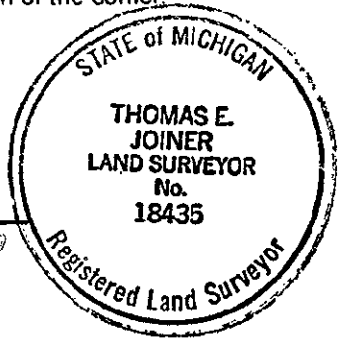

Signed by Thomas E. Joiner Date 11-21-94
 Surveyor's Michigan License No. 18435

2 of 2