

SURVEY & REMONUMENTATION

APR 25 1995

COMMISSION

OTTAWA COUNTY REMONUMENTATION LAND CORNER RECORDATION CERTIFICATE Filing Requirement of Act 74, Mich. P.A. 1970

RECORDED

94 DEC -8 PM 12:28

Phyllis Anderson
REGISTER OF DEEDS
OTTAWA COUNTY, MI

For corners in

OTTAWA

(County)

Located In:

Corner Code ##

Public Land Survey	T	8N	R	16W	E-2, E $\frac{1}{2}$ Corner
	T		R		Section 5
	T		R		Spring Lake Twp.
	T		R		
Property Controlling in Section	S		T	R	
Miscellaneous	S		T	R	
Property in Sec.	S		T	R	

Register of Deeds Stamp & File Number

Lot No. _____, Recorded Plat _____
Private Claims _____

	A	B	C	D	E	F	G	H	I	J	K	L	M
2	6	5	4	3	2	1							
3													
4	7	8	9	10	11	12							
5													
6	18	17	16	15	14	13							
7													
8	19	20	21	22	23	24							
9													
10	30	29	28	27	26	25							
11													
12	31	32	33	34	35	36							
13													


THOMAS E. JOINER in a field survey on 10-13- 19 94,
do hereby certify that under requirements of P.A. 74, Michigan P.A. of 1970, the corner points mentioned in lines 1 and 2 above were in conformance with regulations and rules therefore as required in the current manual of survey instructions of the United States Department of the Interior, Bureau of Land Management or by a decree of a Court of Law and/or that the corner points mentioned in lines 3, 4 and 5 above were in conformance with the rules of the Michigan Board of Land Surveyors or by a Decree of a Court of Law; established, re-established, monumented, re-monumented, recovered, found as expressed below:

NOTE: Not more than 4 corners, all in the same town and range, may be recorded on this certificate.

Description of original monument and accessories and/or subsequent restoration:		
04-01-1837	Liber 4, Pg. 190, 05-27-81	Liber 2, Pg. 93, 03-23-73
Post set by John Mullet	Set Cast Iron Monument	Found Pinched Iron
359W 10 10" Hemlock	N. 32.12 Power Pole	N. 37.09 Power Pole
N30W 26 7" Hemlock	NE 60.96 12" Cherry	SE 64.10 3" Pine
	SE 64.51 8" Pine	
	SSE 34.07 8" Pine	

Description of corner evidence found and/or method applied in restoring or reestablishing corner:

Found Cast Iron Monument in Monument Box and is accepted as a careful and faithful perpetuation of the position of the original corner
Liber 4, Pg. 190, 05-27-81
N 32.12 Power Pole
NE 60.96 12" Cherry
SE 64.51 8" Pine
SSE 34.07 8" Pine

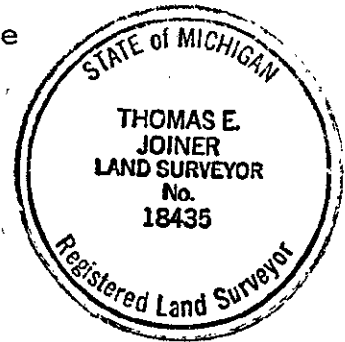

Description of monument for corner and accessories established to perpetuate locating the position of the corner:

Cast Iron Monument in Monument Box

O.C. Remon. Tag & Nail in W side 22" Jack Pine	Az.	15°	59.59
O.C. Remon. Tag & Nail in NW side 12" Cherry	Az.	34°	61.44
O.C. Remon. Tag & Nail in SW side 11" Jack Pine	Az.	128°	64.30
O.C. Remon. Tag & Nail in E side 9" Jack Pine	Az.	164°	34.19

PA. 345 OTTAWA COUNTY

PEER APPROVED 11/21/94

Signed by Thomas E. Joiner Date 11-21-94
Surveyor's Michigan License No. 18435