

SURVEY & REMONUMENTATION

APR 25 1995

COMMISSION

OTTAWA COUNTY REMONUMENTATION.

LAND CORNER RECORDATION CERTIFICATE
 Filing Requirement of Act 74, Mich. P.A. 1970

RECORDED

94 DEC -8 PM 12: 28

For corners in

| | | |
|------------------------------------|--------------------------|------------------|
| <u>OTTAWA</u> (County) | Located in: | Corner Code # |
| 1. Public Land Survey | T <u>8N</u> R <u>16W</u> | E-3, SW Corner |
| | T _____ R _____ | Section 4 |
| | T _____ R _____ | Spring Lake Twp. |
| | T _____ R _____ | |
| 2. Property Controlling in Section | S _____ T _____ R _____ | |
| | S _____ T _____ R _____ | |
| 3. Miscellaneous Property in Sec. | S _____ T _____ R _____ | |
| | S _____ T _____ R _____ | |

D. J. ...
 REGISTER OF DEEDS
 OTTAWA COUNTY, MI

Register of Deeds Stamp & File Number

4. Lot No. _____, Recorded Plat _____
 5. Private Claims _____

| A | B | C | D | E | F | G | H | I | J | K | L | M |
|----|----|----|----|----|----|----|---|---|---|---|---|---|
| 2 | 6 | 5 | 4 | 3 | 2 | 1 | | | | | | |
| 3 | | | | | | | | | | | | |
| 4 | 7 | 8 | 9 | 10 | 11 | 12 | | | | | | |
| 5 | | | | | | | | | | | | |
| 6 | 18 | 17 | 16 | 15 | 14 | 13 | | | | | | |
| 7 | | | | | | | | | | | | |
| 8 | 19 | 20 | 21 | 22 | 23 | 24 | | | | | | |
| 9 | | | | | | | | | | | | |
| 10 | 30 | 29 | 28 | 27 | 26 | 25 | | | | | | |
| 11 | | | | | | | | | | | | |
| 12 | 31 | 32 | 33 | 34 | 35 | 36 | | | | | | |
| 13 | | | | | | | | | | | | |

I, THOMAS E. JOINER in a field survey on 10-13- 19 94, do hereby certify that under requirements of P.A. 74, Michigan P.A. of 1970, the corner points mentioned in lines 1 and 2 above were in conformance with regulations and rules therefore as required in the current manual of survey instructions of the United States Department of the Interior, Bureau of Land Management or by a decree of a Court of Law and/or that the corner points mentioned in lines 3, 4 and 5 above were in conformance with the rules of the Michigan Board of Land Surveyors or by a Decree of a Court of Law; established, re-established, monumented, re-monumented, recovered, found as expressed below:

NOTE: Not more than 4 corners, all in the same town and range, may be recorded on this certificate.

A. Description of original monument and accessories and/or subsequent restoration:
 04-01-1937 Liber 5, Pg. 85, 12-20-83
 Post set by John Mulletts, D.S. Set Cast Iron Monument
 N18°E 5 14" Beech NNE 35.01 Power Pole
 S11°E 16 9" Beech NW 62.80 16" Maple
 S. 28.55 12" Black Cherry
 SE 46.15 14" Black Cherry


Liber 3, Pg. 132, 11-29-76
 Found RR spike in Mon. Box
 NNE 35.00 Power Pole
 NW 62.75 20" Maple
 SW 48.48 8" Cherry
 S. 28.74 12" Cherry

B. Description of corner evidence found and/or method applied in restoring or reestablishing corner:

Found Broken off Cast Iron Monument in Monument Box and accepted as a careful and faithful perpetuation of the position of the original corner.

Liber 5, Pg. 85, 12-20-83
 NNE 35.01 Power Pole
 NW 62.80 16" Maple
 S 28.55 12" Black Cherry
 SE 46.15 14" Black Cherry

Liber 3, Pg. 132, 11-29-76
 NNE 35.00 Power Pole
 NW 62.75 20" Maple
 SW 48.48 8" Cherry
 S 28,74 12" Cherry

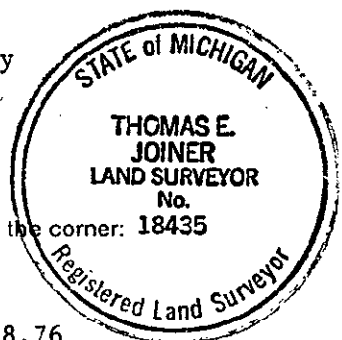

C. Description of monument for corner and accessories established to perpetuate locating the position of the corner:

Broken off cast Iron Monument in Monument Box

| | | |
|---|----------|--------|
| O.C. Remon. Tag & Nail in E side 16" Wild Cherry | Az. 190° | 28.76 |
| O.C. Remon. Tag & Nail in NW side 14" Wild Cherry | Az. 240° | 48.20 |
| O.C. Remon. Tag & Nail in SW side 18" Maple | Az. 311° | 62.75 |
| O.C. Remon. Tag & Nail in W side 24" Maple | Az. 353° | 108.80 |

P.A. 345 OTTAWA COUNTY

PEER APPROVED 11/21/94

Signed by Thomas E. Joiner
 Surveyor's Michigan License No. 18435

Madison D. ...
 Date 11-21-94