

SURVEY & REMONUMENTATION

APR 24 1995

COMMISSION

OTTAWA COUNTY REMONUMENTATION
LAND CORNER RECORDATION CERTIFICATE
 Filing Requirement of Act 74, Mich. P.A. 1970

RECORDED

94 DEC 15 AM 11:46

For corners in

OTTAWA <small>(County)</small>	Located In:	Corner Code #
1. Public Land Survey	T <u>8N</u> R <u>16W</u>	E-9, SE Corner Section 20 Spring Lake Twp.
	T _____ R _____	_____
	T _____ R _____	_____
	T _____ R _____	_____
2. Property Controlling in Section	S _____ T _____ R _____	_____
	S _____ T _____ R _____	_____
3. Miscellaneous Property in Sec.	S _____ T _____ R _____	_____
	S _____ T _____ R _____	_____

Deborah R. Sullivan
 REGISTER OF DEEDS
 OTTAWA COUNTY, MI

Register of Deeds Stamp & File Number

4. Lot No. _____, Recorded Plat _____
 5. Private Claims _____

	A	B	C	D	E	F	G	H	I	J	K	L	M
2	6	5	4	3	2	1							
3													
4	7	8	9	10	11	12							
5													
6	18	17	16	15	14	13							
7													
8	19	20	21	22	23	24							
9													
10	30	29	28	27	26	25							
11													
12	31	32	33	34	35	36							
13													

I, THOMAS E. JOINER in a field survey on 11-22-94, 19 94, do hereby certify that under requirements of P.A. 74, Michigan P.A. of 1970, the corner points mentioned in lines 1 and 2 above were in conformance with regulations and rules therefore as required in the current manual of survey instructions of the United States Department of the Interior, Bureau of Land Management or by a decree of a Court of Law and/or that the corner points mentioned in lines 3, 4 and 5 above were in conformance with the rules of the Michigan Board of Land Surveyors or by a Decree of a Court of Law; established, re-established, monumented, re-monumented, recovered, found as expressed below:


NOTE: Not more than 4 corners, all in the same town and range, may be recorded on this certificate.

A. Description of original monument and accessories and/or subsequent restoration:
 05-27-1832 Liber 2, Pg. 627, 10-09-74
 Post set by John Mullet Found 1" Iron Rod
 N73°E 5 8" Hemlock NW 23.68 Power Pole
 S73°W 10 6" Hemlock ENE 75.23 Power Pole
 SSW 81.44 Power Pole

B. Description of corner evidence found and/or method applied in restoring or reestablishing corner:
 Found 1" Iron Bar in Asphalt and accepted as a careful and faithful perpetuation of the position of the original corner.

Liber 2, Pg. 627, 10-09-74
 ENE 75.23 Power Pole
 SSW 81.44 Power Pole

P.A. 345 OTTAWA COUNTY
 PEER APPROVED 12/12/94
Wendy D. Nedewell

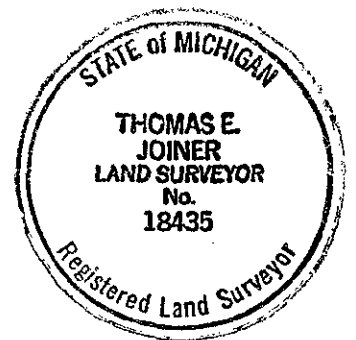

C. Description of monument for corner and accessories established to perpetuate locating the position of the corner:
 Replaced 1" Iron Bar with Cast Iron Monument in Monument Box placed by Materials Testing.

SE Cor. Brick Foundation House #618 (N. Side Pennoyer Ave.)	Az. 55°	80.91
O.C. Remon. Tag & Nail in NE side 8" Maple	Az. 118°	44.19
O.C. Remon. Tag & Nail in NW side 10" Maple	Az. 210°	39.34
O.C. Remon. Tag & Nail in S side 38" Oak	Az. 285°	60.33

Signed by Thomas E. Joiner Date 12-12-94
 Surveyor's Michigan License No. 18435