

**SURVEY &
DOCUMENTATION**

APR 24 1995

OTTAWA COUNTY REMONUMENTATION
LAND CORNER RECORDATION CERTIFICATE
Filing Requirement of Act 74, Mich. P.A. 1970

RECORDED

94 DEC 15 AM 11:46

For corners in
COMMISSION
OTTAWA
(County)

Phyllis Erdmann
REGISTER OF DEEDS
OTTAWA COUNTY, MI

	Located In:	Corner Code #
1. Public Land Survey	T <u>8N</u> R <u>16W</u>	E-10, W $\frac{1}{2}$ Corner
	T _____ R _____	Section 28
	T _____ R _____	Spring Lake Twp.
	T _____ R _____	
2. Property Controlling in Section	S _____ T _____ R _____	
	S _____ T _____ R _____	
3. Miscellaneous Property in Sec.	S _____ T _____ R _____	
	S _____ T _____ R _____	

Register of Deeds Stamp & File Number

4. Lot No. _____, Recorded Plat _____
5. Private Claims _____

	A	B	C	D	E	F	G	H	I	J	K	L	M
2	6	5	4	3	2	1							
3													
4	7	8	9	10	11	12							
5													
6	18	17	16	15	14	13							
7													
8	19	20	21	22	23	24							
9													
10	30	29	28	27	26	25							
11													
12	31	32	33	34	35	36							
13													

I, THOMAS E. JOINER in a field survey on 11-21- 19 94, do hereby certify that under requirements of P.A. 74, Michigan P.A. of 1970, the corner points mentioned in lines 1 and 2 above were in conformance with regulations and rules therefore as required in the current manual of survey instructions of the United States Department of the Interior, Bureau of Land Management or by a decree of a Court of Law and/or that the corner points mentioned in lines 3, 4 and 5 above were in conformance with the rules of the Michigan Board of Land Surveyors or by a Decree of a Court of Law; established, re-established, monumented, re-monumented, recovered, found as expressed below:


NOTE: Not more than 4 corners, all in the same town and range, may be recorded on this certificate.

A. Description of original monument and accessories and/or subsequent restoration:		
05-27-1832	Liber 3, Pg. 349, 06-28-79	Liber 2, Pg. 647, 10-09-74
Post set by John Mullet, D.S.	Found $\frac{1}{2}$ " Pipe in Mon. Box	Found 1" Pipe in Mon. Box
S25°W 6 8" Hemlock	S. 22.50 8" Cherry	S. 22.50 8" Cherry
S45°E 9 6" Hemlock	NNW 19.23 Power Pole	NNW 19.23 Power Pole
	NE 58.00 Power Pole	NE 58.00 Power Pole

B. Description of corner evidence found and/or method applied in restoring or reestablishing corner:

Found Cast Iron Monument in Monument Box and accepted as a careful and faithful perpetuation of the position of the original corner.

Liber 3, Pg. 349, 06-28-79	Liber 2, Pg. 647, 10-09-74
NNW 19.23 Power Pole	NNW 19.23 Power Pole
NE 58.00 Power Pole	NE 58.00 Power Pole

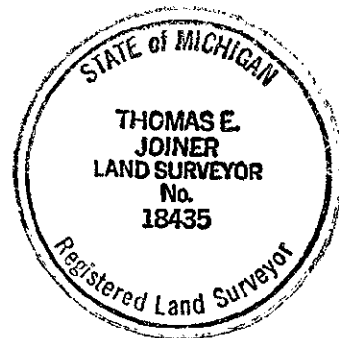

C. Description of monument for corner and accessories established to perpetuate locating the position of the corner:

Cast Iron Monument in Monument Box

O.C. Remon Tag & Nail in NE side 12" Cherry	Az. 165°	38.43
O.C. Remon Tag & Nail in E side 14" Maple	Az. 188°	43.35
SE Corner Conc. Foundation House #1210	Az. 306°	74.48
O.C. Remon Tag & Nail in E side Power Pole	Az. 344°	19.08

P.A. 345 OTTAWA COUNTY
PEER APPROVED *[Signature]*
Date 12-9-94

Signed by Thomas E. Joiner
Surveyor's Michigan License No. 18435