

# SURVEY & REMONUMENTATION

APR 24 1995

COMMISSION

OTTAWA COUNTY REMONUMENTATION  
LAND CORNER RECORDATION CERTIFICATE  
Filing Requirement of Act 74, Mich. P.A. 1970

RECORDED

94 DEC 15 AM 11:46

*Deborah R. Bellman*  
REGISTER OF DEEDS  
OTTAWA COUNTY, MI

For corners in

OTTAWA

(County)

Located In:

Corner Code #

- |                                       |                          |   |
|---------------------------------------|--------------------------|---|
| 1. Public Land Survey                 | T <u>8N</u> R <u>16W</u> | F-9, S $\frac{1}{2}$ Corner<br>Section 21<br>Spring Lake Twp. |
|                                       | T _____ R _____          |   |
|                                       | T _____ R _____          |   |
|                                       | T _____ R _____          |   |
| 2. Property Controlling<br>in Section | S _____ T _____ R _____  |   |
|                                       | S _____ T _____ R _____  |   |
| 3. Miscellaneous<br>Property in Sec.  | S _____ T _____ R _____  |   |
|                                       | S _____ T _____ R _____  |   |
| 4. Lot No. _____, Recorded Plat _____ |                          |   |
| 5. Private Claims _____               |                          |   |

Register of Deeds Stamp & File Number

	A	B	C	D	E	F	G	H	I	J	K	L	M
2	6		5		4		3		2		1		
3													
4	7		8		9		10		11		12		
5													
6	13		17		16		15		14		13		
7													
8	19		20		21		22		23		24		
9					●								
10	30		29		28		27		26		25		
11													
12	31		32		33		34		35		36		
13													

I, THOMAS E. JOINER in a field survey on 11-21-, 19 94, do hereby certify that under requirements of P.A. 74, Michigan P.A. of 1970, the corner points mentioned in lines 1 and 2 above were in conformance with regulations and rules therefore as required in the current manual of survey instructions of the United States Department of the Interior, Bureau of Land Management or by a decree of a Court of Law and/or that the corner points mentioned in lines 3, 4 and 5 above were in conformance with the rules of the Michigan Board of Land Surveyors or by a Decree of a Court of Law; established, re-established, monumented, re-monumented, recovered, found as expressed below:

**NOTE: Not more than 4 corners, all in the same town and range, may be recorded on this certificate.**

A. Description of original monument and accessories and/or subsequent restoration:

05-27-1832	Liber 1, Pg. 627, 09-18-72
Post set by John Mullet, D.S.	Found 3/4" Bar in Monument Box
S 5°W 19 24" Hemlock	SW 35.85 Power Pole
N28°W 47 15" Hemlock	NW 44.62 18" Elm
	NE 43.77 Power Pole
	SE 47.20 18" Maple


B. Description of corner evidence found and/or method applied in restoring or reestablishing corner:

Found 3/4" Iron Bar in Monument Box and accepted as a careful and faithful perpetuation of the position of the original corner.

Liber 1, Pg. 627, 09-18-72  
NE 43.77 Power Pole

P.A. 345 OTTAWA COUNTY  
PEER APPROVED 12/12/94

*Wesley D. Hederson*

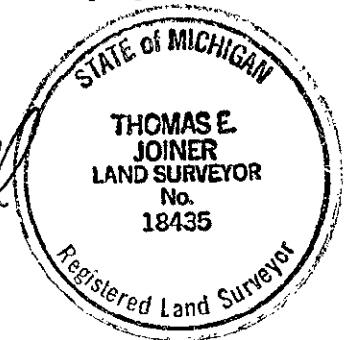

C. Description of monument for corner and accessories established to perpetuate locating the position of the corner:

Replaced 3/4" Iron Bar with Cast Iron Monument in Monument Box

O.C. Remon Tag & Nail in S. side 10" Maple	Az. 70°	54.02
NW cor. conc. Porch Pillar House #1100	Az. 145°	66.50
Q Top Operating Nut on Hydrant	Az. 308°	40.40
O.C. Remon Tag & Nail in E side 24" Maple	Az. 344°	66.35

Signed by

*Thomas E. Joiner*

Date

12-9-94

Surveyor's Michigan License No. 18435