

SURVEY & REMONUMENTATION

APR 24 1995

OTTAWA COUNTY REMONUMENTATION
LAND CORNER RECORDATION CERTIFICATE
 Filing Requirement of Act 74, Mich. P.A. 1970

RECORDED

94 DEC 15 AM 11:53

For corners in **COMMISSION**

Phyllis Ballman
 REGISTER OF DEEDS
 OTTAWA COUNTY, MI

Ottawa (County)	Located In:	Corner Code #
1. Public Land Survey	T 8N R 16W	F-13, S $\frac{1}{2}$ Corner Section 33 Spring Lake Twp.
	T _____ R _____	_____
	T _____ R _____	_____
	T _____ R _____	_____
2. Property Controlling in Section	S _____ T _____ R _____	_____
	S _____ T _____ R _____	_____
3. Miscellaneous Property in Sec.	S _____ T _____ R _____	_____
	S _____ T _____ R _____	_____

Register of Deeds Stamp & File Number

4. Lot No. _____, Recorded Plat _____
 5. Private Claims _____

	A	B	C	D	E	F	G	H	I	J	K	L	M
2	6	5	4	3	2	1							
3													
4	7	8	9	10	11	12							
5													
6	18	17	16	15	14	13							
7													
8	19	20	21	22	23	24							
9													
10	30	29	28	27	26	25							
11													
12	31	32	33	34	35	36							
13													

I, THOMAS E. JOINER, in a field survey on 11-29- 19 99, do hereby certify that under requirements of P.A. 74, Michigan P.A. of 1970, the corner points mentioned in lines 1 and 2 above were in conformance with regulations and rules therefore as required in the current manual of survey instructions of the United States Department of the Interior, Bureau of Land Management or by a decree of a Court of Law and/or that the corner points mentioned in lines 3, 4 and 5 above were in conformance with the rules of the Michigan Board of Land Surveyors or by a Decree of a Court of Law; established, re-established, monumented, re-monumented, recovered, found as expressed below:

NOTE: Not more than 4 corners, all in the same town and range, may be recorded on this certificate.

A. Description of original monument and accessories and/or subsequent restoration:

1837	Liber 5, Pg. 267, 01-16-87
Post set by Calvin Britain, D.S.	Ottawa County Cast Iron Monument
N 72°E 31 6" Black Ash	NE 49.91 Nail South side Power Pole
N 19°W 28 8" Pine	SE 47.37 PK N.E. Side Power Pole
	SSW 33.16 Nail & Cap East Side 18" Pine
	NW 55.25 Head of Boat Spike SE side Power Pole
	West 65.48 Grand Haven Township Corner

(continued on back)

B. Description of corner evidence found and/or method applied in restoring or reestablishing corner:

Found capped iron (PS #28407) 0.1' from edge of and inside of monument box and accepted as a careful and faithful perpetuation of the position of the original corner.

Liber 5, Pg. 267, 01-16-87	Liber 1, Pg. 349, 04-10-72
SE 47.37 PK NE Side Power Pole	SSW 32.6 14" Pine
SSW 33.16 Nail & Cap E Side 18" Pine	NW 55.2 Power Pole
NW 55.25 Head of Boat Spike SE Side Power Pole	W 65.4 Mon. Box N $\frac{1}{2}$ Cor. 4-7-16
West 65.48 Grand Haven Twp. Cor.	


Liber 4, Pg. 300, 04-01-82
 NW 55.25 Power Pole
 SSW 33.13 18" Pine
 West 65.41 Grand Haven Twp. Cor.

P.A. 345 OTTAWA COUNTY
 PEER APPROVED 12/12/94
Wesley D. Hedrick

C. Description of monument for corner and accessories established to perpetuate locating the position of the corner:

Replaced Capped Iron with Cast Iron Monument in Monument Box replaced by Materials Testing.

O.C. Remon. Tag & Nail in SE side Power Pole	Az. 45°	50.42
O.C. Remon. Tag & Nail in NE side Power Pole	Az. 120°	47.40
O.C. Remon. Tag & Nail in E side 30" Jack Pine	Az. 196°	33.10
Top Operating on Hydrant	Az. 278°	55.55
Cast Iron Monument, Grand Haven Twp. Cor. F-1	Az. 270°	65.55

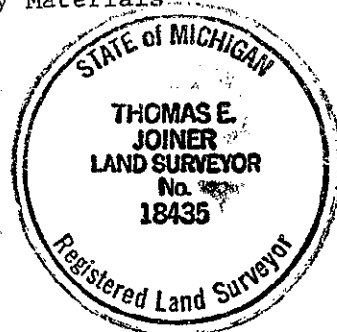

Signed by Thomas E. Joiner Date 12-12-94
 Surveyor's Michigan License No. 18435

Part A (cont.)

Liber 4, Pg. 300, 04-01-82

Set Cast Iron Monument

NW 55.25 Power Pole
NE 49.92 Power Pole
SE 46.78 Guy Pole
SSW 33.13 18" Pine
West 65.41 Grand Haven Corner

Liber 1, Pg. 349, 04-10-72

Found Steel Bar in Mon. Box

SSW 32.6 Nail in face of 14" Pine
NW 55.2 Nail in face of Power Pole
NE 99.8 Nail in face of Telephone Pole
SE 46.7 Nail in face of Guy Pole
West 65.4 Mon. Box N $\frac{1}{2}$ Cor. Section 4-7-16
NNW 54.2 E Hydrant


