

**OTTAWA COUNTY REMONUMENTATION
LAND CORNER RECORDATION CERTIFICATE
Filing Requirement of Act 74, Mich. P.A. 1970**

RECORDED

94 DEC 15 AM 11:45

By: [Signature]
REGISTER OF DEEDS
OTTAWA COUNTY, MI

**SURVEY &
REMONUMENTATION**

JEC 05 2000

Register of Deeds Stamp & File Number

For corners in <u>Ottawa</u> <small>(County)</small>	Located In:	Corner Code #
1. Public Land Survey	T <u>8N</u> R <u>16W</u>	<u>G-13, SE Corner</u>
	T _____ R _____	<u>Section 33</u>
	T _____ R _____	<u>Spring Lake Twp.</u>
	T _____ R _____	_____
2. Property Controlling in Section	S _____ T _____ R _____	_____
	S _____ T _____ R _____	_____
3. Miscellaneous Property in Sec.	S _____ T _____ R _____	_____
	S _____ T _____ R _____	_____
4. Lot No. _____, Recorded Plat _____		
5. Private Claims _____		

A	B	C	D	E	F	G	H	I	J	K	L	M
2	5	5	4	3	2	1						
3												
4	7	8	9	10	11	12						
5												
6	18	17	16	15	14	13						
7												
8	19	20	21	22	23	24						
9												
10	30	29	28	27	26	25						
11												
12	31	32	33	34	35	36						
13												

I, THOMAS E. JOINER in a field survey on 11-29-1994, do hereby certify that under requirements of P.A. 74, Michigan P.A. of 1970, the corner points mentioned in lines 1 and 2 above were in conformance with regulations and rules therefore as required in the current manual of survey instructions of the United States Department of the Interior, Bureau of Land Management or by a decree of a Court of Law and/or that the corner points mentioned in lines 3, 4 and 5 above were in conformance with the rules of the Michigan Board of Land Surveyors or by a Decree of a Court of Law; established, re-established, monumented, re-monumented, recovered, found as expressed below:


NOTE: Not more than 4 corners, all in the same town and range, may be recorded on this certificate.

- A. Description of original monument and accessories and/or subsequent restoration:
- | | | |
|---|---|---|
| 1837
Post set by Calvin Britain, D.S.
N 32°E 19 6" Hemlock
N 29°W 18 12" Beech | Liber 4, Pg. 300, 04-01-82
Cast Iron Monument
South 36.58 Power Pole
NE 81.07 Power Pole
SE 45.60 12" Pine
West 54.52 Grand Haven
Township Corner | Liber 1, Pg. 349, 04-10-72
1" Pinched Pipe
ENE 64.8 Spike in Telephone Pole
South 36.6 Nail in face of Power Pole
WNW 82.7 Nail in face of Telephone Pole
NW 100.2 Nail in face of 24" Basswood
West 54.1 Mon. Box NE Cor Sec 4
West 20.0 East edge Pavement |
|---|---|---|
- B. Description of corner evidence found and/or method applied in restoring or reestablishing corner:

Found Cast Iron Monument in Monument Box and accepted as a careful and faithful perpetuation of the position of the original corner.

Liber 4, Pg. 300, 04-01-82 NE 81.07 Power Pole West 54.52 Grand Haven Twp. Cor.	Liber 1, Pg. 349, 04-10-72 NW 100.2 Nail in face of 24" Basswood West 54.1 Mon. Box NE cor. Sec. 4
---	--

P.A. 345 OTTAWA COUNTY
DEED APPROVED 12/12/94

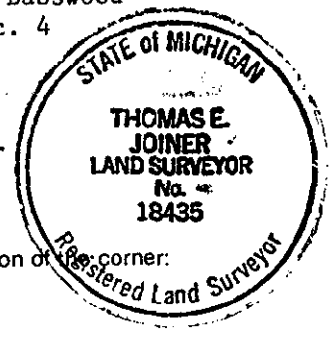

- C. Description of monument for corner and accessories established to perpetuate locating the position of corner:
- Found Cast Iron Monument in Monument Box
- | | |
|---|---|
| O.C. Remon. Tag & Nail in E side 12" Maple
NE Cor. House #14394
E Top Operating Nut on Hydrant
O.C. Remon. Tag & Nail in SW side 36" Basswood
Cast Iron Monument, Grand Haven Twp. Cor. G-1 | Az. 12° 40.65
Az. 146° 91.15
Az. 284° 118.49
Az. 315° 101.64
Az. 270° 54.52 |
|---|---|

Signed by Thomas E. Joiner Date 12-17-94
Surveyor's Michigan License No. 18435

FORM APPROVED BY MICHIGAN STATE BOARD OF LAND SURVEYORS, JAN. 28, 1971
REVISED MAY 14, 1975
REVISED JAN., 1983