

OTTAWA COUNTY REMONUMENTATION
 LAND CORNER RECORDATION CERTIFICATE
 Filing Requirement of Act 74, Mich. P.A. 1970

RECORDED

94 MAY -6 AM 10:55


For corners in

OTTAWA (County)	Located In:	Corner Code #
1. Public Land Survey	T 8N R 16W	H-5, S $\frac{1}{4}$ Corner
	T _____ R _____	Section 10
	T _____ R _____	Spring Lake Twp.
	T _____ R _____	
2. Property Controlling in Section	S _____ T _____ R _____	
	S _____ T _____ R _____	
3. Miscellaneous Property in Sec.	S _____ T _____ R _____	
	S _____ T _____ R _____	

Phyllis Whitman
 REGISTER OF DEEDS
 OTTAWA COUNTY, MI

Register of Deeds Stamp & File Number

4. Lot No. _____, Recorded Plat _____
 5. Private Claims _____

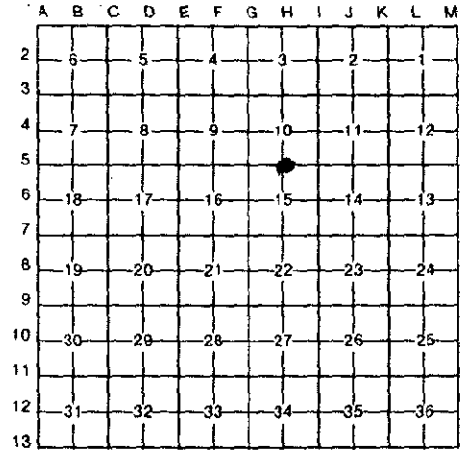

I, THOMAS E. JOINER in a field survey on APRIL 11, 19 94
 do hereby certify that under requirements of P.A. 74, Michigan P.A. of 1970, the corner points mentioned
 in lines 1 and 2 above were in conformance with regulations and rules therefore as required in the
 current manual of survey instructions of the United States Department of the Interior, Bureau of Land
 Management or by a decree of a Court of Law and/or that the corner points mentioned in lines 3, 4 and 5
 above were in conformance with the rules of the Michigan Board of Land Surveyors or by a Decree of a
 Court of Law; established, re-established, monumented, re-monumented, recovered, found as
 expressed below:

**NOTE: Not more than 4 corners, all in the same town and range, may be recorded
 on this certificate.**

A. Description of original monument and accessories and/or subsequent restoration:

03-30-87	Liber 4, Pg. 293, 01-29-82
Post set by John Mullet, D.S.	Liber 5, Pg. 34, 03-04-83
N02°W 08 5" Beech	Set Cast Iron Monument
S15°W 05 8" Beech	N5°E 26.84 Nail South Side 30" Maple
	NE 47.00 P.K. & Ribbon South Side 24" Maple
	SE 45.60 Ribbon NE Side Telephone Pole
	SSW 48.69 P.K. West Root 30" Maple
	SW 26.29 Bent Nail North Side Power Pole

B. Description of corner evidence found and/or method applied in restoring or reestablishing corner:


Found Cast Iron Monument in Monument Box and accepted as a careful and faithful
 perpetuation of the position of the original corner.

N5°E	26.84	30" Maple
NE	47.00	24" Maple
SW	26.29	Power Pole

SURVEY &
 REMONUMENTATION

OCT 24 1994

COMMISSION

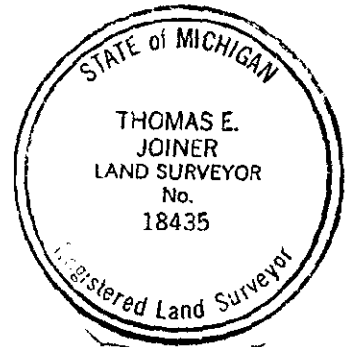

C. Description of monument for corner and accessories established to perpetuate locating the position of the corner:

Cast Iron Monument on Monument Box

O.C. Tag & Nail in NW Side 36" Maple	Az. 52°30'	47.30
O.C. Tag & Nail in NE Side Power Pole	Az. 98°32'	90.36
O.C. Tag & Nail in SE Side Power Pole	Az. 226°36'	26.55
O.C. Tag & Nail in West Side Power Pole	Az. 00°00'	40.09

PEER APPROVED 4/10/94
Gordon D. Hedewell
 Date 4-15-94

Signed by Thomas E. Joiner
 Surveyor's Michigan License No. 18435