

**OTTAWA COUNTY REMONUMENTATION
LAND CORNER RECORDATION CERTIFICATE
Filing Requirement of Act 74, Mich. P.A. 1970**

RECORDED

96 DEC 18 PM 4:55

Robert A. Anderson
REGISTER OF DEEDS
OTTAWA COUNTY, MI

For corners in

Ottawa <small>(County)</small>	Located In:	Corner Code #
1. Public Land Survey	T <u>8N</u> R <u>16W</u>	H-7, S $\frac{1}{2}$ corner Section 15 Spring Lake Twp
	T _____ R _____	_____
	T _____ R _____	_____
	T _____ R _____	_____
2. Property Controlling in Section	S _____ T _____ R _____	_____
	S _____ T _____ R _____	_____
3. Miscellaneous Property in Sec.	S _____ T _____ R _____	_____
	S _____ T _____ R _____	_____

Register of Deeds Stamp & File Number

4. Lot No. _____, Recorded Plat _____
5. Private Claims _____

	A	B	C	D	E	F	G	H	I	J	K	L	M
2	6	5	4	3	2								
3													
4	7	8	9	10	11	12							
5													
6	18	17	16	15	14	13							
7													
8	19	20	21	22	23	24							
9													
10	30	29	28	27	26	25							
11													
12	31	32	33	34	35	36							
13													

I, Thomas E. Joiner, in a field survey on September 17, 19 96, do hereby certify that under requirements of P.A. 74, Michigan P.A. of 1970, the corner points mentioned in lines 1 and 2 above were in conformance with regulations and rules therefore as required in the current manual of survey instructions of the United States Department of the Interior, Bureau of Land Management or by a decree of a Court of Law and/or that the corner points mentioned in lines 3, 4 and 5 above were in conformance with the rules of the Michigan Board of Land Surveyors or by a Decree of a Court of Law, established, re-established, monumented, re-monumented, recovered, found as expressed below:

NOTE: Not more than 4 corners, all in the same town and range, may be recorded on this certificate.

-7A. Description of original monument and accessories and/or subsequent restoration:

Gov't. Notes Page 277
John Mullett D.S.
Set Quarter Section Post
40.05 Chains From Southeast
Section Corner 15 - 8 - 16, True Line
12" Pine S 22° W 31 Links
10" White Oak S 52 $\frac{1}{2}$ ° E 70 Links

P.A. 345 OTTAWA COUNTY
PEER APPROVED 12-9-96
T.E.J.

-B. Description of corner evidence found and/or method applied in restoring or reestablishing corner:

Found 3/8" Iron Bar In Concrete And Accepted As A Careful & Faithful Perpetuation Of The Original Corner. Set Monument Box. Unable To Completely Remove 3/8" Iron In Concrete. Bent Iron Over And Set 12" Long Iron Bar With Ottawa County Remon. Cap.


H-7 is also described as being the Southwest corner of Hopkins Addition, Liber 13 on Page 153.

See drawing on reverse side.

H-7 was checked with dimension with the plat of Hopkins Addition. Numerous surveys in Hopkins Addition have been based off of H-7. Numerous surveys in that part of the Northwest $\frac{1}{4}$ of the Northeast $\frac{1}{4}$ of Section 22, Town 8 North, Range 16 West, have been based off of H-7.

Description of monument for corner and accessories established to perpetuate locating the position of the corner:

H-7
Set 12" Long Steel Bar With Ottawa County Remon. Cap. Set Monument Box.
Ottawa County Remon tag and nail in S Side Power Pole AZ 241° Dist. 22.86
Ottawa County Remon tag and nail in E Side 27" Maple AZ 340° Dist. 71.35
Ottawa County Remon tag and nail in NW Side Power Pole AZ 37° Dist. 36.29
Ottawa County Remon tag and nail in S Side 26" Maple AZ 103° Dist. 57.92

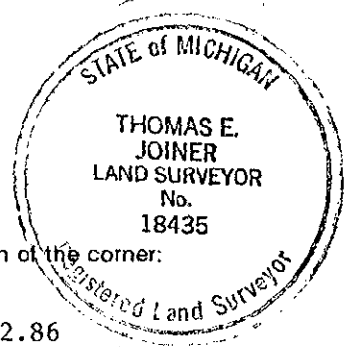

Recorded by Thomas E. Joiner Date 12-6-96
Surveyor's Michigan License No. 18435

