

SURVEY & REMONUMENTATION

APR 24 1995

COMMISSION

**OTTAWA COUNTY REMONUMENTATION
LAND CORNER RECORDATION CERTIFICATE
Filing Requirement of Act 74, Mich. P.A. 1970**

RECORDED

94 DEC 15 AM 11:45

Deborah K. Ballman
REGISTER OF DEEDS
OTTAWA COUNTY, MI

For corners in
OTTAWA

(County)	Located In:	Corner Code #
1. Public Land Survey	T 8N R 16W	H-13, S 1/4 Corner Section 34 Spring Lake Twp.
	T _____ R _____	_____
	T _____ R _____	_____
	T _____ R _____	_____
2. Property Controlling in Section	S _____ T _____ R _____	_____
	S _____ T _____ R _____	_____
3. Miscellaneous Property in Sec.	S _____ T _____ R _____	_____
	S _____ T _____ R _____	_____

Register of Deeds Stamp & File Number

4. Lot No. _____, Recorded Plat _____
5. Private Claims _____

	A	B	C	D	E	F	G	H	I	J	K	L	M
2	6	5	4	3	2	1							
3													
4	7	8	9	10	11	12							
5													
6	18	17	16	15	14	13							
7													
8	19	20	21	22	23	24							
9													
10	30	29	28	27	26	25							
11													
12	31	32	33	34	35	36							
13													

I, THOMAS E. JOINER (in a field survey on 11-22- 19 94), do hereby certify that under requirements of P.A. 74, Michigan P.A. of 1970, the corner points mentioned in lines 1 and 2 above were in conformance with regulations and rules therefore as required in the current manual of survey instructions of the United States Department of the Interior, Bureau of Land Management or by a decree of a Court of Law and/or that the corner points mentioned in lines 3, 4 and 5 above were in conformance with the rules of the Michigan Board of Land Surveyors or by a Decree of a Court of Law; established, re-established, monumented, re-monumented, recovered, found as expressed below:

NOTE: Not more than 4 corners, all in the same town and range, may be recorded on this certificate.

A. Description of original monument and accessories and/or subsequent restoration:


1837	Liber 4, Pg. 300, 04-01-82	Liber 1, Pg. 667, 10-13-72
Post set by Calvin Britain, D.S.	Set Cast Iron Monument	Found steel bolt w/1 1/2" top
N57°E 29 10" Beech	SW 61.83 18" Maple	SW 61.05 14" Willow
N10°W 13 18" Beech	SE 105.14 Power Pole	SW 61.80 12" Maple
	NW 47.80 Center of Hydrant	SE 45.30 16" Cherry
	W. 52.28 Gr. Hv. Twp. Cor.	SE 95.65 NE Hse. Cor.
		SE 85.30 NW Hse. Cor.

B. Description of corner evidence found and/or method applied in restoring or reestablishing corner:

Found Broken Off Cast Iron Monument in Monument Box and accepted as a careful and faithful perpetuation of the position of the original corner.

Liber 4, Pg. 300, 04-01-82
NW 47.80 Center of Hydrant
W 52.28 Grand Haven Township Corner

OTTAWA COUNTY
PEER APPROVED 12/12/94
Wendy D. Nedewell

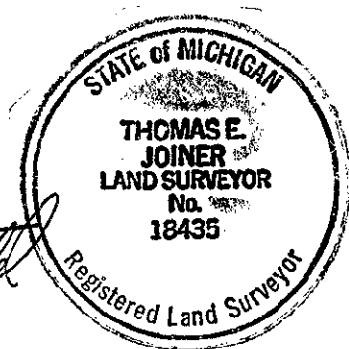

C. Description of monument for corner and accessories established to perpetuate locating the position of the corner:

Broken off Cast Iron Monument in Monument Box		
O.C. Remon Tag & Nail in NW side 11" Cedar	Az. 150°	73.38
O.C. Remon Tag & Nail in NW side 12" Blue Spruce	Az. 190°	35.90
O.C. Remon Tag & Nail in SE side 10" Oak	Az. 236°	68.05
Q Top Operating Nut on Hydrant	Az. 312°	47.76
Cast Iron Monument in Monument Box, Grand Haven Twp. Corner G-1	Az. 270°	52.30

Signed by Thomas E. Joiner Date 12-9-94
Surveyor's Michigan License No. 18435

FORM APPROVED BY MICHIGAN STATE BOARD OF LAND SURVEYORS, JAN. 28, 1971
REVISED MAY 14, 1975
REVISED JAN., 1983