

**OTTAWA COUNTY REMONUMENTATION  
LAND CORNER RECORDATION CERTIFICATE  
Filing Requirement of Act 74, Mich. P.A. 1970**

For corners in

<u>Ottawa</u> (County)	Located In: Grand Haven Twp.	Corner Code # <u>I-9</u>
1. Public Land Survey	T 8N R 16W	Reference corner to meander post and NW corner
2. Property Controlling in Section	S ___ T ___ R ___	Section 27
3. Miscellaneous Property in Sec.	S ___ T ___ R ___	<u>Sec. #2</u>

**RECORDED**  
96 DEC 20 PM 12:20  
*Phyllis Robinson*  
REGISTER OF DEEDS  
OTTAWA COUNTY, MI  
**Register of Deeds Stamp & File Number**

4. Lot No. \_\_\_\_\_; Recorded Plat \_\_\_\_\_  
5. Private Claims \_\_\_\_\_

I, Carl P. Englert, in a field survey on 11/25, 1996, do hereby state that under requirements of P.A. 74, Michigan P.A. of 1970, the corner points mentioned in lines 1 and 2 above were in conformance with regulations and rules therefore as required in the current manual of survey instructions of the United States Department of the Interior, Bureau of Land Management or by a decree of a Court of Law and /or that the corner points mentioned in lines 3, 4 and 5 above were in conformance with the rules of the Michigan Board of Land Surveyors or by a Decree of a Court of Law; established, re-established, monumented, recovered, found as expressed below:

NOTE: Not more than 2 corners, all in the same town and range, may be recorded on this certificate.

1	A	B	C	D	E	F	G	H	I	J	K	L	M
2		6		5		4		3		2		1	
3													
4		7		8		9		10		11		12	
5													
6		18		17		16		15		14		13	
7													
8		19		20		21		22		23		24	
9													
10		30		29		28		27		26		25	
11													
12		31		32		33		34		35		36	
13													

A. Description of original monument and accessories and/or subsequent restoration:

I-9 corner common to Sections 22, 23, 26 & 27	
GLO Britain 1832	Mullett 1837
49.00 Grand River	49.00 Post on Left Bank Grand River
& set Meander Post	80.00 Set post common to Sections 22, 23, 26 & 27 on Island on Low Wetland
Tamarack 10" S18°W 2.75 ch.	Raised a mound

P.A. 345 OTTAWA COUNTY

PEER APPROVED 12-9-96

B. Description of corner evidence found and/or method applied in restoring or reestablishing corner:

*C. P. N.*

I-9 Corner common to Sections 22, 23, 26 & 27  
Meander Post and I-9 Lost  
Established Meander Post measuring 9 chains with 1832 chain  
North on the extension of Line I-11 to I-10  
Established I-9 by double prop. measurement from Meander Post (1832)  
on South bank of River and corner I-7 and Meander Post on South line  
of Section 22 and J-9

Accepted as a careful and faithful reestablishment of the position of the original corner.

C. Description of monument for corner and accessories established to perpetuate locating the position of the corner:


I-9 corner common to Sections 22, 23, 26 & 27  
Reference corner to 1832 Meander Post and I-9, Set 3/4"x3' Iron Bar with Remon Cap

O.C. Remon tag & nail in S. Side 16" Willow	N70°E	84.23'
O.C. Remon tag & nail in N. Side 16" Tree	N58°W	161.67'
O.C. Remon tag & nail in E. Side 10" Oak	S18°W	101.35'
O.C. Remon tag & nail in W. Side 5" Sassafras	S33°E	83.29'
South 25'± to N. edge of cul de sac pavement		See Other Side

\$ 1.00 PHOTO  
\$ 1.00 PHOTO

Signed by Carl P. Englert  
Surveyor's Michigan License No. 10987

Date 12/13/96

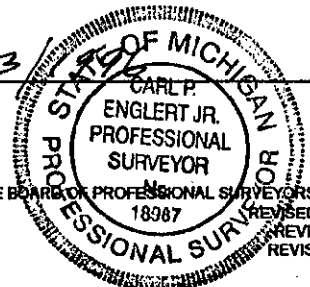

N

P.O.B.  
Boejen's SUB.  
Liber 13, Page 58

E.C.M.

69.70'


I-7

00°02'28"  
52.55.25'  
40' G.L.O.

I-8

0°34'40" 2655.25'  
40' chains G.L.O.

Scale: 1" = 1000'

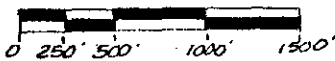

Bearings from Holland  
Engineering Survey

M.P. of end of 1832 survey  
shown on 1871 monument map  
& Monroe, Howlett & Cutler's Add.  
Liber 1, page 68

Ref. cor. 1852.62'

N. 89°18'00" E. of G-9

G-9

89°18'00"

1980.00'  
30 chains G.L.O.

90°03'51"

696.11'

H-9

10.4 chains  
G.L.O.

90°03'51" 2677.34'

40 chains  
G.L.O.

I-9

90°06'46" 2690.72'

40.2 chains  
G.L.O.

J-9

2058.05'

358°52'53"

31 chains  
G.L.O.

31 chains  
G.L.O.

M.P. at end of  
1832 survey

9 chains  
G.L.O.

358°28'00"  
600.37 using 1832 chain

I-10

Ref. cor. 110.30'  
N. 01°32'00" W. of  
I-10

13.8992'

00.52.856

I-11

I-9 set by double prop. measurement  
from M.P. 1832 survey to J-9 and  
M.P. 1832 survey on line between  
section 26 & 27 and I-7

I-8 set by single prop. measurement  
holding east line between I-7 & I-8

I-9 set by single prop. measurement  
between M.P. 1832 survey and I-9  
as established above

M.P. = meander post