

**SURVEY & REMONUMENTATION**

APR 24 1995

COMMISSION

OTTAWA COUNTY REMONUMENTATION

LAND CORNER RECORDATION CERTIFICATE  
Filing Requirement of Act 74, Mich. P.A. 1970

RECORDED

94 DEC 15 AM 11:45

For corners in

OTTAWA (County)	Located In:	Corner Code #
1. Public Land Survey	T <u>8N</u> R <u>16W</u>	<u>I-13, SE Corner</u>
	T _____ R _____	<u>Section 34</u>
	T _____ R _____	<u>Spring Lake Twp.</u>
	T _____ R _____	_____
2. Property Controlling in Section	S _____ T _____ R _____	_____
	S _____ T _____ R _____	_____
3. Miscellaneous Property in Sec.	S _____ T _____ R _____	_____
	S _____ T _____ R _____	_____

*Polly Ann Ballman*  
REGISTER OF DEEDS  
OTTAWA COUNTY, MI

Register of Deeds Stamp & File Number

4. Lot No. \_\_\_\_\_, Recorded Plat \_\_\_\_\_  
5. Private Claims \_\_\_\_\_

	A	B	C	D	E	F	G	H	I	J	K	L	M
2	6	5	4	3	2	1							
3													
4	7	8	9	10	11	12							
5													
6	18	17	16	15	14	13							
7													
8	19	20	21	22	23	24							
9													
10	30	29	28	27	26	25							
11													
12	31	32	33	34	35	36							
13													

I, THOMAS E. JOINER in a field survey on 11-21- 19 94, do hereby certify that under requirements of P.A. 74, Michigan P.A. of 1970, the corner points mentioned in lines 1 and 2 above were in conformance with regulations and rules therefore as required in the current manual of survey instructions of the United States Department of the Interior, Bureau of Land Management or by a decree of a Court of Law and/or that the corner points mentioned in lines 3, 4 and 5 above were in conformance with the rules of the Michigan Board of Land Surveyors or by a Decree of a Court of Law; established, re-established, monumented, re-monumented, recovered, found as expressed below:

**NOTE: Not more than 4 corners, all in the same town and range, may be recorded on this certificate.**

A. Description of original monument and accessories and/or subsequent restoration:

1837	Liber 4, Pg. 297, 04-01-82	Liber 1, Pg. 667, 11-13-72
Post set by Calvin Britain, D.S.	Set Cast Iron Monument	Found angle iron
N32°W 55 10" White Oak	NW 31.80 Power Pole	E. 21.92 10" Aspen
N70°E 8 24" White Oak	W. 44.50 9" Ironwood	NW 31.65 Power Pole
	SW 52.84 8" Ironwood	SW 42.00 Manhole face
	W. 21.50 Grand Hvn. Twp. Cor.	W 21.50 Gr. Hvn. Twp. Corner

B. Description of corner evidence found and/or method applied in restoring or reestablishing corner:

Found Cast Iron Monument in Monument Box and accepted as a careful and faithful perpetuation of the position of the original corner.

Liber 4, Pg. 297, 04-01-82	Liber 1, Pg. 667, 11-13-72
NW 31.80 Power Pole	NW 31.65 Power Pole
W 44.50 9" Ironwood	W 21.50 Grand Haven Twp. Cor.
SW 52.84 8" Ironwood	
W 21.50 Grand Haven Twp. Cor.	


P.A. 345 OTTAWA COUNTY

PEER APPROVED 12/12/94  
*Wesley D. Peterson*

C. Description of monument for corner and accessories established to perpetuate locating the position of the corner:

Cast Iron Monument in Monument Box

Q Top Operating Nut on Hydrant	Az. 15°	90.83'
SW Cor. Brick House #14400	Az. 52°	70.23
O.C. Remon Tag & Nail in NE side 12" Maple	Az. 295°	47.32
O.C. Remon Tag & Nail in S side 28" Yellow Birch	Az. 316°	59.49
Cast Iron Monument, Grand Haven Twp. Cor. I-1	Az. 270°	21.50

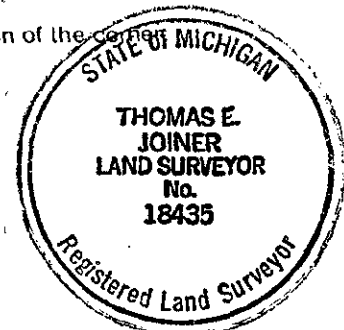

Signed by Thomas E. Joiner Date 12-9-94  
Surveyor's Michigan License No. 18435