

**SURVEY &  
REMONUMENTATION**

APR 05 1996

**COMMISSION**

For corners in

**OTTAWA COUNTY REMONUMENTATION  
LAND CORNER RECORDATION CERTIFICATE  
Filing Requirement of Act 74, Mich. P.A. 1970**

<u>Ottawa</u> (County)	Located In:	Corner Code #
1. Public Land Survey	T <u>8N</u> R <u>16W</u>	<u>J-3, S<math>\frac{1}{2}</math> Corner</u> <u>Section 2</u> <u>Spring Lake Twp</u>
	T ___ R ___	_____
	T ___ R ___	_____
	T ___ R ___	_____
2. Property Controlling in Section	S ___ T ___ R ___	_____
	S ___ T ___ R ___	_____
3. Miscellaneous Property in Sec.	S ___ T ___ R ___	_____
	S ___ T ___ R ___	_____
4. Lot No. _____, Recorded Plat _____		
5. Private Claims _____		

RECORDED

95 NOV 29 PM 1:34

*Daphne R. Holloman*  
REGISTER OF DEEDS  
OTTAWA COUNTY, MI

Register of Deeds Stamp & File Number

I, Thomas E. Joiner, in a field survey on 11-9-, 19 95, do hereby certify that under requirements of P.A. 74, Michigan P.A. of 1970, the corner points mentioned in lines 1 and 2 above were in conformance with regulations and rules therefore as required in the current manual of survey instructions of the United States Department of the Interior, Bureau of Land Management or by a decree of a Court of Law and/or that the corner points mentioned in lines 3, 4 and 5 above were in conformance with the rules of the Michigan Board of Land Surveyors or by a Decree of a Court of Law; established, re-established, monumented, re-monumented, recovered, found as expressed below:

A	B	C	D	E	F	G	H	I	J	K	L
2	6	5	4	3	2	1					
3											
4	7	8	9	10	11	12					
5											
6	18	17	16	15	14	13					
7											
8	19	20	21	22	23	24					
9											
10	30	29	28	27	26	25					
11											
12	31	32	33	34	35	36					
13											

**NOTE: Not more than 4 corners, all in the same town and range, may be recorded on this certificate.**

**A. Description of original monument and accessories and/or subsequent restoration:**

03-31-1837	Liber 2, Page 105	04-13-73	Liber 4, Page 294
Post Set By J. Mullett	Found 1" Pipe		Found 1" Pipe
S 21° E 1.10 16" Pine	NW 29.50 Guy Pole		Set Cast Iron Monument
N 16½° W 1.54 14" Pine	W 36.84 36" Oak		NW 29.48 Nail is SE side of Guy Pole
	SW 44.88 20" Oak		E 29.00 Nail in W side of Power Pol.
	E 29.00 Power Pole		SW 44.83 Nail in NE side of 20" Oak
			W 36.19 Nail in E side of 36" Oak

**B. Description of corner evidence found and/or method applied in restoring or reestablishing corner:**

Found Cast Iron Monument in Monument Box and accepted as a careful and faithful perpetuation of the position of the original corner.

Liber 4, Page 294  
W 36.19 Nail and Washer E side 36" Oak  
SW 44.83 Nail and Washer NE side 20" Oak  
E 29.00 Nail and Washer W side P.P.


P.A. 345 OTTAWA COUNTY  
PEER APPROVED 11/20/95

*Madison D. Redwood*  
*YDP*

**C. Description of monument for corner and accessories established to perpetuate locating the position of the corner:**

Cast Iron Monument

O.C. Remon Tag & Nail in NW side of 20" Oak	AZ 228°	45.67
O.C. Remon Tag & Nail in NE side of 34" Oak	AZ 329°	62.22
O.C. Remon Tag & Nail in NW side of 21" White Pine	AZ 40°	66.00
Q Top Operating Bolt on Hydrant	AZ 135°	31.39

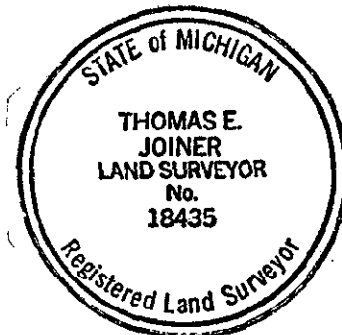

Signed by Thomas E. Joiner  
Surveyor's Michigan License No. 18435

Date 11-16-95