

SURVEY & REMONUMENTATION

APR 05 1996

**OTTAWA COUNTY REMONUMENTATION
LAND CORNER RECORDATION CERTIFICATE
Filing Requirement of Act 74, Mich. P.A. 1970**

For corners in **COMMISSION**

| Ottawa (County) | Located In: | Corner Code # |
|---------------------------------------|--------------------------|--------------------------------------------------------------|
| 1. Public Land Survey | T <u>8N</u> R <u>16W</u> | J-9, S $\frac{1}{2}$ corner Section 23 Spring Lake Twp |
| | T _____ R _____ | _____ |
| | T _____ R _____ | _____ |
| | T _____ R _____ | _____ |
| 2. Property Controlling in Section | S _____ T _____ R _____ | _____ |
| | S _____ T _____ R _____ | _____ |
| 3. Miscellaneous Property in Sec. | S _____ T _____ R _____ | _____ |
| | S _____ T _____ R _____ | _____ |

RECORDED

95 NOV 29 PM 1:36

Reginald D. Redwood
REGISTER OF DEEDS
OTTAWA COUNTY, MI

Register of Deeds Stamp & File Number

- 4. Lot No. _____, Recorded Plat _____
- 5. Private Claims _____

| | A | B | C | D | E | F | G | H | I | J | K | L | M |
|----|----|---|----|---|----|---|----|---|----|---|----|---|---|
| 2 | 6 | | 5 | | 4 | | 3 | | 2 | | 1 | | |
| 3 | | | | | | | | | | | | | |
| 4 | 7 | | 8 | | 9 | | 10 | | 11 | | 12 | | |
| 5 | | | | | | | | | | | | | |
| 6 | 18 | | 17 | | 16 | | 15 | | 14 | | 13 | | |
| 7 | | | | | | | | | | | | | |
| 8 | 19 | | 20 | | 21 | | 22 | | 23 | | 24 | | |
| 9 | | | | | | | | | | | | | |
| 10 | 30 | | 29 | | 28 | | 27 | | 26 | | 25 | | |
| 11 | | | | | | | | | | | | | |
| 12 | 31 | | 32 | | 33 | | 34 | | 35 | | 36 | | |
| 13 | | | | | | | | | | | | | |

I, Thomas E. Joiner, in a field survey on 11/7, 19 95, do hereby certify that under requirements of P.A. 74, Michigan P.A. of 1970, the corner points mentioned in lines 1 and 2 above were in conformance with regulations and rules therefore as required in the current manual of survey instructions of the United States Department of the Interior, Bureau of Land Management or by a decree of a Court of Law and/or that the corner points mentioned in lines 3, 4 and 5 above were in conformance with the rules of the Michigan Board of Land Surveyors or by a Decree of a Court of Law; established, re-established, monumented, re-monumented, recovered, found as expressed below:

NOTE: Not more than 4 corners, all in the same town and range, may be recorded on this certificate.

A. Description of original monument and accessories and/or subsequent restoration:

| | | | | |
|-------------------------------------|---------------------------|----------|-----------------------------|----------|
| 03-28-1837 | Liber 3, Page 30 | 01-29-76 | Liber 4, Page 9 | 12-11-79 |
| Post Set By Calvin Britain, D.S. | Found Conc. Monument | | Set Cast Iron Monument | |
| N 27 $\frac{1}{2}$ °W 1.54 14" Pine | 28" Maple | NE 43.81 | Quad. Maple | NW 45.06 |
| N 27°E 2.50 7" Bl. Oak | Power Pole | N 53.90 | Power Pole | N 53.90 |
| | G _L Leonard Rd | N 106.20 | 30" Maple | NE 43.81 |
| | | | G _L Leonard Road | N 106.00 |

B. Description of corner evidence found and/or method applied in restoring or reestablishing corner:

Found Cast Iron Monument in Monument Box and accepted as a careful and faithful perpetuation of the position of the original corner.


| | |
|---------------------------|----------|
| Liber 4, Page 9 | |
| Quad Maple | NW 45.06 |
| Power Pole | N 53.90 |
| 30" Maple | NE 43.81 |
| G _L Leonard Rd | N 106.00 |

RA. 345 OTTAWA COUNTY
PEER APPROVED 11/20/95
Reginald D. Redwood
Tom

C. Description of monument for corner and accessories established to perpetuate locating the position of the corner:

Cast Iron Monument

| | | | | |
|---------------------------------|------------------|----|------|-------|
| O.C. Remon Tag & Nail in W side | 30" Maple | AZ | 45° | 44.52 |
| O.C. Remon Tag & Nail in E side | Power Pole | AZ | 4° | 53.90 |
| O.C. Remon Tag & Nail in E side | 20" Triple Maple | AZ | 345° | 47.77 |
| O.C. Remon Tag & Nail in S side | 6" Maple | AZ | 138° | 19.33 |

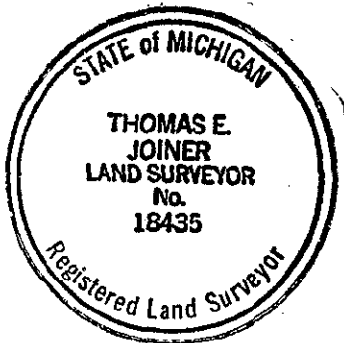

Signed by Thomas E. Joiner Date 11-16-95
Surveyor's Michigan License No. 18435