

**SURVEY &
REMONUMENTATION**

APR 24 1995

COMMISSION

OTTAWA COUNTY REMONUMENTATION
LAND CORNER RECORDATION CERTIFICATE
Filing Requirement of Act 74, Mich. P.A. 1970

RECORDED

94 DEC 15 AM 11:45

For corners in

Ottawa
(County)

Located In:

Corner Code ##

- | | | |
|---------------------------------------|--------------------------|---|
| 1. Public Land Survey | T <u>8N</u> R <u>16W</u> | J-11, S $\frac{1}{4}$ Cor.
Section 26
Spring Lake Twp |
| | T _____ R _____ | _____ |
| | T _____ R _____ | _____ |
| | T _____ R _____ | _____ |
| 2. Property Controlling
in Section | S _____ T _____ R _____ | _____ |
| | S _____ T _____ R _____ | _____ |
| 3. Miscellaneous
Property in Sec. | S _____ T _____ R _____ | _____ |
| | S _____ T _____ R _____ | _____ |

Phyllis Kallman
REGISTER OF DEEDS
OTTAWA COUNTY, MI

Register of Deeds Stamp & File Number

4. Lot No. _____, Recorded Plat _____
5. Private Claims _____

	A	B	C	D	E	F	G	H	I	J	K	L	M
2	6	5	4	3	2	1							
3													
4	7	8	9	10	11	12							
5													
6	18	17	16	15	14	13							
7													
8	19	20	21	22	23	24							
9													
10	30	29	28	27	26	25							
11													
12	31	32	33	34	35	36							
13													

I, THOMAS E. JOINER in a field survey on 11-29-, 19 94, do hereby certify that under requirements of P.A. 74, Michigan P.A. of 1970, the corner points mentioned in lines 1 and 2 above were in conformance with regulations and rules therefore as required in the current manual of survey instructions of the United States Department of the Interior, Bureau of Land Management or by a decree of a Court of Law and/or that the corner points mentioned in lines 3, 4 and 5 above were in conformance with the rules of the Michigan Board of Land Surveyors or by a Decree of a Court of Law; established, re-established, monumented, re-monumented, recovered, found as expressed below:

NOTE: Not more than 4 corners, all in the same town and range, may be recorded on this certificate.


A. Description of original monument and accessories and/or subsequent restoration:

05-26-1832	Liber 3, Pg. 372, 07-27-79	Liber 1, Pg. 277, 02-15-72
Post Set by Calvin Britain, D.S.	Set Cast Iron Monument	Found Iron Pipe
S 56°E 22 15" White Oak	North 34.47 36" Oak	North 33.00 Iron Pipe
N 66°W 14 10" Black Oak	NW 82.34 20" Oak	NE 66.59 Nail in face of 8" White Oak
	South 24.38 P. Pole	South 33.00 Conc. Monument
	SE 36.97 19" Oak	NE 89.82 SW Cor. Hse. #15619
		NE 109.71 SE Cor. Hse. #15619

B. Description of corner evidence found and/or method applied in restoring or reestablishing corner:

Found Cast Iron Monument in Monument Box and accepted as a careful and faithful perpetuation of the position of the original corner.

Liber 3, Pg. 372, 07-27-79	Liber 1, Pg. 277, 02-15-72
North 34.47 36" Oak	North 33.00 Iron Pipe
	NE 89.82 SW Cor. Hse. #15619
	NE 109.71 SE Cor. Hse. #15619

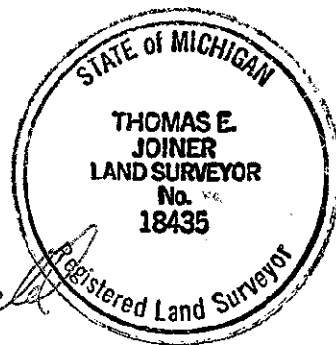

P.A. 345 OTTAWA COUNTY
PEER APPROVED 12/12/94
 Gordon D. Hedrick

C. Description of monument for corner and accessories established to perpetuate locating the position of the corner:

Cast Iron Monument in Monument Box

O.C. Remon. Tag & Nail in E side 43" White Oak	Az. 00° 35.68
SW Cor. Conc. Block foundation Hse. #15619	Az. 28° 89.82
O.C. Remon. Tag & Nail in NE side 8" Spruce	Az. 140° 41.85
O.C. Remon. Tag & Nail in E side 12" Spruce	Az. 218° 47.06

Signed by Thomas E. Joiner
Surveyor's Michigan License No. 18435

Date 12-12-94