

**SURVEY &
MONUMENTATION**

APR 24 1995

OTTAWA COUNTY REMONUMENTATION
LAND CORNER RECORDATION CERTIFICATE
Filing Requirement of Act 74, Mich. P.A. 1970

RECORDED

94 DEC 15 AM 11:46

For corners in **COMMISSION**

D. P. ...
REGISTER OF DEEDS
OTTAWA COUNTY, MI

Ottawa (County)	Located In:	Corner Code #
1. Public Land Survey	T 8N R 16W	K-3, SW Cor.
	T _____ R _____	Section 1
	T _____ R _____	Spring Lake Twp.
	T _____ R _____	
2. Property Controlling in Section	S _____ T _____ R _____	
	S _____ T _____ R _____	
3. Miscellaneous Property in Sec.	S _____ T _____ R _____	
	S _____ T _____ R _____	

Register of Deeds Stamp & File Number

4. Lot No. _____, Recorded Plat _____
5. Private Claims _____

	A	B	C	D	E	F	G	H	I	J	K	L	M
2	6	5	4	3	2	1							
3													
4	7	8	9	10	11	12							
5													
6	18	17	16	15	14	13							
7													
8	19	20	21	22	23	24							
9													
10	30	29	28	27	26	25							
11													
12	31	32	33	34	35	36							
13													

I, THOMAS E. JOINER in a field survey on 11-29-94, 1994, do hereby certify that under requirements of P.A. 74, Michigan P.A. of 1970, the corner points mentioned in lines 1 and 2 above were in conformance with regulations and rules therefore as required in the current manual of survey instructions of the United States Department of the Interior, Bureau of Land Management or by a decree of a Court of Law and/or that the corner points mentioned in lines 3, 4 and 5 above were in conformance with the rules of the Michigan Board of Land Surveyors or by a Decree of a Court of Law; established, re-established, monumented, re-monumented, recovered, found as expressed below:

NOTE: Not more than 4 corners, all in the same town and range, may be recorded on this certificate.

A. Description of original monument and accessories and/or subsequent restoration:

03-28-1837 Post Set by John Mullet, D.S. N 35°E 34 18" W. Oak N 68°W 08 14" W. Oak	Liber 3, Pg. 182, 09-16-77 Found 1/2" x 1 1/2" Steel Bar West 14.50 20" Oak South 27.75 10" Twin Cherry NE 36.82 10" Pine	Liber 6, Pg. 236, 09-15-92 Found Cast Iron Monument West 15.33 40-D Nail N side 20" Oak WNW 25.80 Fnd. Nail & Cap Ely side 12" Oak NE 36.30 Fnd. Nail & Cap SW side 14" Pine South 27.72 Fnd. Nail & Cap N side Twin 8" Cherry On line with downed fence to East
---	---	--

B. Description of corner evidence found and/or method applied in restoring or reestablishing corner:

Found Cast Iron Monument and accepted as a careful and faithful perpetuation of the position of the original corner.


Liber 3, Pg. 182, 09-16-77 West 14.50 20" Oak South 27.75 10" Twin Cherry NE 36.82 10" Pine	Liber 6, Pg. 236, 09-15-92 West 15.33 40-D Nail N side 20" Oak WNW 25.80 Fnd. Nail & Cap Ely Side 12" Oak NE 36.30 Fnd. Nail & Cap SW Side 14" Pine South 27.72 Fnd. Nail & Cap N Side Twin 8" Cherry
Liber 4, Pg. 49, 04-14-80 WNW 14.48 20" Red Oak South 27.75 10" Twin Cherry NE 36.55 13" White Pine NW 25.84 12" White Oak	

P.A. 345 OTTAWA COUNTY

PEER APPROVED 12/12/94
Wendy D. ...

C. Description of monument for corner and accessories established to perpetuate locating the position of the corner:

Cast Iron Monument	
O.C. Remon. Tag & Nail in NW side 20" White Pine	Az. 58° 37.00
O.C. Remon. Tag & Nail in NE side 7" Maple	Az. 164° 31.96
O.C. Remon. Tag & Nail in N side 24" Oak	Az. 277° 15.32
O.C. Remon. Tag & Nail in side 12" Oak	Az. 306° 26.35

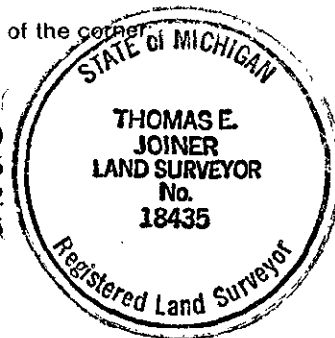

Signed by Thomas E. Joiner Date 12-12-94
Surveyor's Michigan License No. 18435