

RECORDED

1992

COMMISSION

OTTAWA COUNTY REMONUMENTATION
LAND CORNER RECORDATION CERTIFICATE
Filing Requirement of Act 74, Mich. P.A. 1970

RECORDED

93 DEC 16 PM 1:01

Regina Bullman
REGISTER OF DEEDS
OTTAWA COUNTY, MI

For corners in

Ottawa (County)	Located In:	Corner Code #
1. Public Land Survey	T 8N R 16W	K-5 N.W. corner Section 13
	T R	
	T R	
	T R	
2. Property Controlling in Section	S T R	
	S T R	
3. Miscellaneous Property in Sec.	S T R	
	S T R	

Register of Deeds Stamp & File Number

4. Lot No. _____, Recorded Plat _____
5. Private Claims _____

I, THOMAS E. JOINER in a field survey on 10-28- 19 93, do hereby certify that under requirements of P.A. 74, Michigan P.A. of 1970, the corner points mentioned in lines 1 and 2 above were in conformance with regulations and rules therefore as required in the current manual of survey instructions of the United States Department of the Interior, Bureau of Land Management or by a decree of a Court of Law and/or that the corner points mentioned in lines 3, 4 and 5 above were in conformance with the rules of the Michigan Board of Land Surveyors or by a Decree of a Court of Law; established, re-established, monumented, re-monumented, recovered, found as expressed below:

NOTE: Not more than 4 corners, all in the same town and range, may be recorded on this certificate.


A. Description of original monument and accessories and/or subsequent restoration:

Well Point	Cast Iron Monument	Liber 1, Pg. 149	11-23-71
	N.E.	25.76	12" Ash
	North	10.30	16" Ash
	West	19.58	18" Ash
	S.W.	5.62	10" Ash
	South	8.84	16" Ash

B. Description of corner evidence found and/or method applied in restoring or reestablishing corner:

Found cast iron monument and accepted as a careful and faithful perpetuation of the position of the original corner.

N.E.	27.76	12" Ash
North	10.30	16" Ash
S.W.	5.62	10" Ash

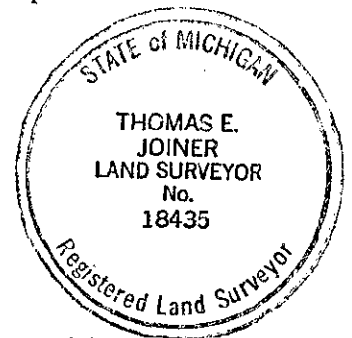

C. Description of monument for corner and accessories established to perpetuate locating the position of the corner.

Cast Iron Monument

O.C. Remon tag & nail in South side of 24" Ash	AZ. 271° 11' 00"	20.93
O.C. Remon tag & nail West side of Twin Ash	AZ. 05° 10' 00"	11.11
O.C. Remon tag & nail S.W. side of 18" Ash	AZ. 144° 14' 00"	12.34
O.C. Remon tag & nail North side of 8" Beech	AZ. 115° 47' 00"	8.64

Signed by Thomas E. Joiner Date 11-4-93
Surveyor's Michigan License No. 18435