

RECORDED

OTTAWA COUNTY REMONUMENTATION
LAND CORNER RECORDATION CERTIFICATE
Filing Requirement of Act 74, Mich. P.A. 1970

93 DEC 16 PM 1:01

Regina Chittman
REGISTER OF DEEDS
OTTAWA COUNTY, MI

For corners in
Ottawa
(County)

Located In: Corner Code #

- 1. Public Land Survey T 8N R 16W K-9, SW corner
T _____ R _____ Section 24
T _____ R _____
T _____ R _____
- 2. Property Controlling S _____ T _____ R _____
in Section S _____ T _____ R _____
- 3. Miscellaneous S _____ T _____ R _____
Property in Sec. S _____ T _____ R _____

Register of Deeds Stamp & File Number

- 4. Lot No. _____, Recorded Plat _____
- 5. Private Claims _____

	A	B	C	D	E	F	G	H	I	J	K	L	M
2	6	5	4	3	2								
3													
4	7	8	9	10	11	12							
5													
6	18	17	16	15	14	13							
7													
8	19	20	21	22	23	24							
9													
10	30	29	28	27	26	25							
11													
12	31	32	33	34	35	36							
13													

I, THOMAS E. JOINER in a field survey on 11-3- 19 93, do hereby certify that under requirements of P.A. 74, Michigan P.A. of 1970, the corner points mentioned in lines 1 and 2 above were in conformance with regulations and rules therefore as required in the current manual of survey instructions of the United States Department of the Interior, Bureau of Land Management or by a decree of a Court of Law and/or that the corner points mentioned in lines 3, 4 and 5 above were in conformance with the rules of the Michigan Board of Land Surveyors or by a Decree of a Court of Law; established, re-established, monumented, re-monumented, recovered, found as expressed below.

NOTE: Not more than 4 corners, all in the same town and range, may be recorded on this certificate.

A. Description of original monument and accessories and/or subsequent restoration:

Found 3/4" Pipe in Monument Box

Set Cast Iron Monument Liber 5, Pg. 93
12-20-83


Powerpole N.W. 38.38
Powerpole S.W. 39.03
20" Oak S.E. 57.85

Powerpole S.W. 39.00
Powerpole N.E. 47.11
Tele. Pole N.W. 46.05
NW cor bdg S.E. 71.87

B. Description of corner evidence found and/or method applied in restoring or reestablishing corner:

Found cast iron monument and accepted as a careful and faithful perpetuation of the position of the original corner.

N.W. Corner building S.E. 71.87
Powerpole N.E. 47.11
Tele. Pole N.W. 46.05
Powerpole S.W. 39.00

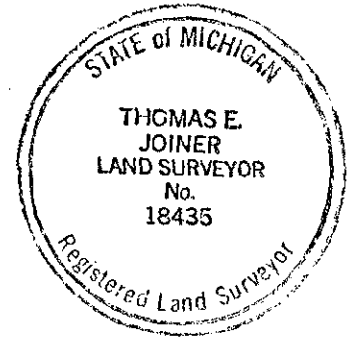

C. Description of monument for corner and accessories established to perpetuate locating the position of the corner:

Cast Iron Monument

O.C. Remon tag & nail in N.W. face powerpole AZ. 43° 32' 06" 47.05
O.C. Remon tag & nail East face powerpole AZ. 322° 18' 00" 45.66
O.C. Remon tag & nail S.E. face powerpole AZ. 229° 00' 00" 39.08
O.C. Remon tag & nail S.W. face powerpole AZ. 104° 00' 20" 111.26

Signed by Thomas E. Joiner
Surveyor's Michigan License No. 18435

Date 11-19-93