

SURVEY & REMONUMENTATION

APR 24 1995

OTTAWA COUNTY REMONUMENTATION
LAND CORNER RECORDATION CERTIFICATE
Filing Requirement of Act 74, Mich. P.A. 1970

RECORDED

94 DEC 15 AM 11:46

COMMISSION

For corners in

Ottawa <small>(County)</small>	Located In:	Corner Code #
1. Public Land Survey	T <u>8N</u> R <u>16W</u>	K-11, Common Cor to Sections <u>25, 26, 35 & 36</u> <u>Spring Lake Twp.</u>
	T _____ R _____	_____
	T _____ R _____	_____
	T _____ R _____	_____
2. Property Controlling in Section	S _____ T _____ R _____	_____
	S _____ T _____ R _____	_____
3. Miscellaneous Property in Sec.	S _____ T _____ R _____	_____
	S _____ T _____ R _____	_____

Phyllis Robinson
REGISTER OF DEEDS
OTTAWA COUNTY, MI

Register of Deeds Stamp & File Number

4. Lot No. _____, Recorded Plat _____
5. Private Claims _____

	A	B	C	D	E	F	G	H	I	J	K	L	M
2	6	5	4	3	2	1							
3													
4	7	8	9	10	11	12							
5													
6	18	17	16	15	14	13							
7													
8	19	20	21	22	23	24							
9													
10	30	29	28	27	26	25							
11													
12	31	32	33	34	35	36							
13													

I, THOMAS E. JOINER in a field survey on 11-29- 19 94, do hereby certify that under requirements of P.A. 74, Michigan P.A. of 1970, the corner points mentioned in lines 1 and 2 above were in conformance with regulations and rules therefore as required in the current manual of survey instructions of the United States Department of the Interior, Bureau of Land Management or by a decree of a Court of Law and/or that the corner points mentioned in lines 3, 4 and 5 above were in conformance with the rules of the Michigan Board of Land Surveyors or by a Decree of a Court of Law; established, re-established, monumented, re-monumented, recovered, found as expressed below:

NOTE: Not more than 4 corners, all in the same town and range, may be recorded on this certificate.

- A. Description of original monument and accessories and/or subsequent restoration:
- | | | |
|----------------------------------|---|--------------------------|
| 05-26-1832 | Liber 1, Pg. 277, 02-15-72 | Liber 4, Pg. 191, |
| Post Set by Calvin Britain, D.S. | Found 1" Gas Pipe | 05-27-81 |
| S 11°W 45 10" Birch | N 60°W 47.61 Nail in face of 34" Willow | Set Cast Iron Monument |
| N 45°W 29 12" B. Ash | S 45°W 60.46 Nail in face of 28" Birch | SW 60.50 28" White Birch |
| | East 17.12 Nail in face of P.P. | |
| | S 45°W 45.48 Ⓢ Street Sign | SW 71.01 8" Maple |
| | | NW 67.20 Cen. of Hyd. |
| | | NE 34.80 Power Pole |


- B. Description of corner evidence found and/or method applied in restoring or reestablishing corner:

Found Cast Iron Monument in Monument Box and accepted as a careful and faithful perpetuation of the position of the original corner.

Liber 4, Pg. 191, 05-27-81
NW 67.20 Cen. of Hydrant
NE 34.80 Power Pole

P.A. 345 OTTAWA COUNTY
PEER APPROVED 12/12/94

Wesley D. Medowell

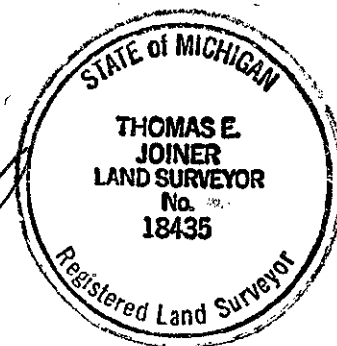

- C. Description of monument for corner and accessories established to perpetuate locating the position of the corner:

Cast Iron Monument in Monument Box

O.C. Remon. Tag & Nail in S side Power/Light Pole	Az. 55°	34.77
O.C. Remon. Tag & Nail in E side 38" Oak	Az. 200°	118.55
Ⓢ Top Operating Nut on Hydrant	Az. 295°	67.08
O.C. Remon. Tag & Nail in SE side 8" Willow	Az. 356°	47.14

Signed by Thomas E. Joiner Date 12-12-94
Surveyor's Michigan License No. 18435