

**SURVEY &
MONUMENTATION**

APR 24 1995

COMMISSION

OTTAWA COUNTY REMONUMENTATION
LAND CORNER RECORDATION CERTIFICATE
Filing Requirement of Act 74, Mich. P.A. 1970

RECORDED

96 DEC 15 AM 11:46

Regina A. Adamson
REGISTER OF DEEDS
OTTAWA COUNTY, MI

For corners in

Ottawa (County)	Located in:	Corner Code #
1. Public Land Survey	T 8N R 16W	K-12, E 1/2 Cor. Section 35 Spring Lake Twp.
	T R	
	T R	
	T R	
2. Property Controlling in Section	S T R	
	S T R	
3. Miscellaneous Property in Sec.	S T R	
	S T R	

Register of Deeds Stamp & File Number

4. Lot No. _____, Recorded Plat _____
5. Private Claims _____

	A	B	C	D	E	F	G	H	I	J	K	L	M
2	6	5	4	3	2	1							
3													
4	7	8	9	10	11	12							
5													
6	18	17	16	15	14	13							
7													
8	19	20	21	22	23	24							
9													
10	30	29	28	27	26	25							
11													
12	31	32	33	34	35	36							
13													

I, THOMAS E. JOINER, in a field survey on 11-29- 19 94, do hereby certify that under requirements of P.A. 74, Michigan P.A. of 1970, the corner points mentioned in lines 1 and 2 above were in conformance with regulations and rules therefore as required in the current manual of survey instructions of the United States Department of the Interior, Bureau of Land Management or by a decree of a Court of Law and/or that the corner points mentioned in lines 3, 4 and 5 above were in conformance with the rules of the Michigan Board of Land Surveyors or by a Decree of a Court of Law; established, re-established, monumented, re-monumented, recovered, found as expressed below:

NOTE: Not more than 4 corners, all in the same town and range, may be recorded on this certificate.


A. Description of original monument and accessories and/or subsequent restoration:

05-26-1832	Liber 1, Pg. 277, 02-15-72	Liber 4, Pg. 200, 06-25-8
Post Set by Calvin Britain, D.S.	Found Iron Pipe	Set Cast Iron Monument
S 45°E 30 30" Pine	SE 32.64 Nail in face of 30" Oak	East 51.51 Power Pole
N 62°W 34 36" Pine	NE 61.03 SW cor. Hse. #14792	SE 36.43 Street Sign
	SE 75.58 NW cor. Hse. #14770	West 25.80 Power Pole
	West 66.69 NE cor. Hse. #14785	SE 75.62 NW cor. Hse. #14770
	East 19.16 E St. Sign	

B. Description of corner evidence found and/or method applied in restoring or reestablishing corner:

Found Cast Iron Monument in Monument Box and accepted as a careful and faithful perpetuation of the position of the original corner.

Liber 1, Pg. 277, 02-15-72	Liber 4, Pg. 200, 06-25-81
NE 61.03 SW Cor. Hse. #14792	East 51.51 Power Pole
SE 75.58 NW Cor. Hse. #14770	SE 36.43 Street Sign
West 66.69 NE Cor. Hse. #14785	West 25.80 Power Pole
	SE 75.62 NW Cor. Hse. #14770

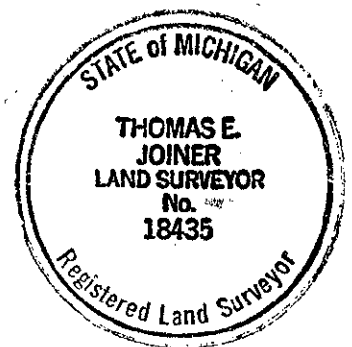

PA. 345 OTTAWA COUNTY
PEER APPROVED 12/12/94

C. Description of monument for corner and accessories established to perpetuate the position of the corner:

Cast Iron Monument in Monument Box

SW Cor. siding House #14792	Az. 77°	61.13
NW Cor. Conc. Block Foundation House #14770	Az. 134°	75.63
NE Cor. Brick Hse. #14785	Az. 252°	66.70
O.C. Remon. Tag & Nail in NE side 19" Oak	Az. 297°	43.80

Signed by Thomas E. Joiner
Surveyor's Michigan License No. 18435

Date 12-12-94