

OTTAWA COUNTY REMONUMENTATION  
**LAND CORNER RECORDATION CERTIFICATE**  
 Filing Requirement of Act 74, Mich. P.A. 1970

RECORDED

94 MAY -6 AM 10:55

For corners in

OTTAWA  
 (County)

Located In:

Corner Code -#

1. Public Land Survey T 8N R 16W L-5 N $\frac{1}{2}$  Corner  
 T \_\_\_\_\_ R \_\_\_\_\_ Section 13  
 T \_\_\_\_\_ R \_\_\_\_\_ Spring Lake Twp.  
 T \_\_\_\_\_ R \_\_\_\_\_
2. Property Controlling S \_\_\_\_\_ T \_\_\_\_\_ R \_\_\_\_\_  
 in Section S \_\_\_\_\_ T \_\_\_\_\_ R \_\_\_\_\_
3. Miscellaneous S \_\_\_\_\_ T \_\_\_\_\_ R \_\_\_\_\_  
 Property in Sec. S \_\_\_\_\_ T \_\_\_\_\_ R \_\_\_\_\_
4. Lot No. \_\_\_\_\_, Recorded Plat \_\_\_\_\_
5. Private Claims \_\_\_\_\_

*Richard R. Williams*  
 REGISTER OF DEEDS  
 OTTAWA COUNTY, MI

Register of Deeds Stamp & File Number

I, THOMAS E. JOINER in a field survey on APRIL 12, 19 94, do hereby certify that under requirements of P.A. 74, Michigan P.A. of 1970, the corner points mentioned in lines 1 and 2 above were in conformance with regulations and rules therefore as required in the current manual of survey instructions of the United States Department of the Interior, Bureau of Land Management or by a decree of a Court of Law and/or that the corner points mentioned in lines 3, 4 and 5 above were in conformance with the rules of the Michigan Board of Land Surveyors or by a Decree of a Court of Law; established, re-established, monumented, re-monumented, recovered, found as expressed below:

**NOTE: Not more than 4 corners, all in the same town and range, may be recorded on this certificate.**

A. Description of original monument and accessories and/or subsequent restoration:

03-28-1837

Post set by John Mullet

N 38°E 16 18" Pine

S 08°E 18 30" Pine

Liber 1, Pg. 81, 09-24-71

Liber 1, Pg. 91, 10-04-71

Liber 5, Pg. 65, 09-22-83

ENE 52.65 12" Pine

SE 48.58 Power Pole

WSW 40.05  $\text{\textcircled{C}}$  Hydrant

NW 92.32 SE Corner Garage

B. Description of corner evidence found and/or method applied in restoring or reestablishing corner:

Found Cast Iron Monument and accepted as a careful and faithful perpetuation of the position of the original corner.

WSW 40.05  $\text{\textcircled{C}}$  Hydrant


SE 48.58 Power Pole

NW 92.32 SE Corner Garage

SURVEY &  
 REMONUMENTATION

OCT 24 1994

COMMISSION

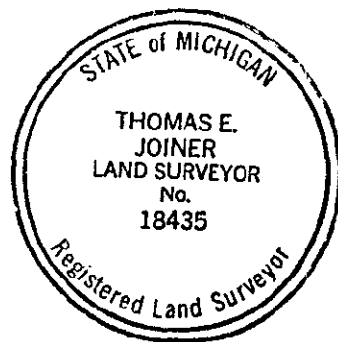

C. Description of monument for corner and accessories established to perpetuate locating the position of the corner:

Cast Iron Monument in Monument Box

O.C. Remon. Tag & Nail in Ease side of twin 18" Maple

Az. 327°22' 58.58

O.C. Remon. Tag & Nail in SW side of Power Pole

Az. 131°38' 49.05

O.C. Remon. Tag & Nail in West side of 10" White Pine

Az. 208°39' 82.00

Az. 245°30'

RA. 046 OTTAWA COUNTY

FEES APPROVED

*Harvey D. Medwell*

Signed by Thomas E. Joiner

Date 4-15-94

Surveyor's Michigan License No. 18435