

**SURVEY & REMONUMENTATION**

JUN 28 1999

**OTTAWA COUNTY REMONUMENTATION  
LAND CORNER RECORDATION CERTIFICATE**  
Filing Requirement of Act 74, Mich. P.A. 1970

RECORDED  
98 NOV -4 PM 2: 31

For corners in **SECTION**

OTTAWA Located In: \_\_\_\_\_ Corner Code # \_\_\_\_\_  
(County)

1. Public Land Survey T 8N R 16W L 7  
T \_\_\_\_\_ R \_\_\_\_\_ N ¼ 24  
T \_\_\_\_\_ R \_\_\_\_\_ SPRING LAKE TWP  
T \_\_\_\_\_ R \_\_\_\_\_

2. Property Controlling S \_\_\_\_\_ T \_\_\_\_\_ R \_\_\_\_\_  
in Section S \_\_\_\_\_ T \_\_\_\_\_ R \_\_\_\_\_

3. Miscellaneous S \_\_\_\_\_ T \_\_\_\_\_ R \_\_\_\_\_  
Property in Sec. S \_\_\_\_\_ T \_\_\_\_\_ R \_\_\_\_\_

4. Lot No. \_\_\_\_\_, Recorded Plat \_\_\_\_\_

5. Private Claims \_\_\_\_\_

*Sam H. Heltzer*  
REGISTER OF DEEDS  
OTTAWA COUNTY, MI

Register of Deeds Stamp & File Number

I, Robert E. Lemke, in a field survey on May 7, 1998 do hereby state that under requirements of P.A. 74, Michigan P.A. of 1970, the corner points mentioned in lines 1 and 2 above were in conformance with regulations and rules therefore as required in the current manual of survey instructions of the United States Department of the Interior, Bureau of Land Management or by a decree of a Court of Law and /or that the corner points mentioned in lines 3, 4 and 5 above were in conformance with the rules of the Michigan Board of Land Surveyors or by a Decree of a Court of Law; established, re-established, monumented, recovered, found as expressed below:

NOTE: Not more than 2 corners, all in the same town and range, may be recorded on this certificate.

	A	B	C	D	E	F	G	H	I	J	K	L	M
1													
2	6		5		4		3		2		1		
3													
4	7		8		9		10		11		12		
5													
6	18		17		16		15		14		13		
7													
8	19		20		21		22		23		24		
9													
10	30		29		28		27		26		25		
11													
12	31		32		33		34		35		36		
13													


A. Description of original monument and accessories and/or subsequent restoration:  
( SEE BACK OF PAGE )

B. Description of corner evidence found and/or method applied in restoring or reestablishing corner:

Found Ottawa County Remon Marker in Monument Box @ CL/CL M104 & 148<sup>th</sup> Ave.  
Found Nail & O.C. tag, in S root of 24" Oak NW 104.66 (m = 104.57') witnesses per Liber 5, Pg. 217 LCRC  
And is accepted as a careful and faithful perpetuation of the position of the original corner.

C. Description of monument for corner and accessories established to perpetuate locating the position of the corner:

Ottawa County Remon Marker in monument box (west edge).  
Found O.C. nail & tag, 1.0' above grade in the SE side of a Power Pole S 45° W 68.35'  
Found O.C. nail & tag, 0.5' above grade in the SW side of a 24" Oak N 25° W 104.57'  
Set O.C. nail & tag, 0.9' above grade in the SE side of a Power Pole N 45° E 66.63'  
Set O.C. nail & tag, 1.0' above grade in the NE side of a Power Pole S 30° E 64.14'  
Corner is at the intersections of the centerlines of M104 & 148<sup>th</sup> Avenue.

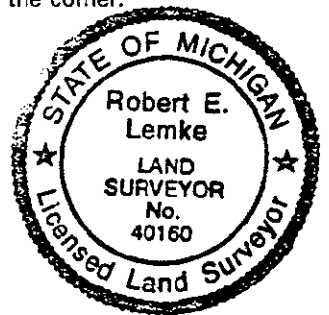

APPROVED REMONUMENTATION CORNER  
P.A.345 OF 1990  
OTTAWA COUNTY

DATE APPROVED \_\_\_\_\_

COUNTY REP. \_\_\_\_\_

Signed by *Robert E. Lemke*  
SDI Consultants, Ltd.  
Surveyor's Michigan License No. 40160

Date 5/7/98

\$11.00 CORNER  
 Receipt # 107  
 \$2.00 PHOTO  
 Receipt # 111  
 MAY 14 1998  
 REVISED JAN., 1983  
 REVISED OCT., 1995

FORM APPROVED BY MICHIGAN STATE BOARD OF PROFESSIONAL SURVEYORS.

GLO  
40.15 Ch. Set quarter section post true line  
W. Oak 18" S 24° W 19 lks  
Hemlock 18" N 44° E 10 lks

County Survey notes  
N 1/4 sec. 24  
State Highway Dept. Lead Plug  
Sec. Sec. 13  
37" Oak N 35° E 37.76'  
28" Oak N 28° E 38.75'  
30" Oak S 59° W 61.30'

SURVEY &  
REMONUMENTATION

JUN 28 1999

SECTION

LCRC Nov. 29, 1972 (Liber 1, page 779)  
C.P. Englert Jr.  
Found RR Spike in Monument Box  
NE PP 58.34'  
SW PP 60.96'  
SE TP 60.62'

LCRC October 08, 1980 (Liber 4, page 113)  
J.G. Campbell  
Found steel Bar in Monument Box  
S 40° W P. Pole 60.95'  
S 40° E G. Pole 60.64'  
N 30° E P. Pole 58.40'

LCRC May 10, 1985 (Liber 5, page 217)  
A. Brintnall  
Found 1" Steel Bar @ West edge of Monument Box  
Part B  
S 40° W P. Pole 60.95'  
S 40° E G. Pole 60.64'  
N 30° E P. Pole 58.40'  
Part C  
Set Nail in NW side of P. Pole SW 60.88'  
Set Nail in SW side of P. Pole SE 60.52'  
Set Nail in NW side of P. Pole NE 58.32'  
Set Nail in S root of 24" Oak NW 104.66'

Act 132 Survey December 14, 1995 (not recorded)  
Prein & Newhof, A. Brintnall  
North 1/4 corner Section 24,  
FND 3/4" solid Rod in Monument Box  
NE 58.38' Nail NW side PP  
SE 56.10' CL ST. sign  
SW 60.74' Nail/Tag NW side PP  
NW 104.75' Nail S. Root 24" Oak