

DEC 01 1998

**SECTION**

**OTTAWA COUNTY REMONUMENTATION  
LAND CORNER RECORDATION CERTIFICATE  
Filing Requirement of Act 74, Mich. P.A. 1970**

For corners in

<u>Ottawa</u> <small>(County)</small>	Located In:	Corner Code #
1. Public Land Survey	T <u>8</u> N R <u>16</u> W	L-13
	T _____ R _____	_____
	T _____ R _____	_____
	T _____ R _____	_____
2. Property Controlling in Section	S _____ T _____ R _____	South 1/4 corner
	S _____ T _____ R _____	Section 36
3. Miscellaneous Property in Sec.	S _____ T _____ R _____	Spring Lake Twp
	S _____ T _____ R _____	_____

**RECORDED**

98 JUL 24 PM 1:45

*Henry J. Lampen*  
REGISTER OF DEEDS  
OTTAWA COUNTY, MI

**Register of Deeds Stamp & File Number**

4. Lot No. \_\_\_\_\_, Recorded Plat \_\_\_\_\_  
5. Private Claims \_\_\_\_\_

I, Steve Lampen, in a field survey on June 4 19 98, do hereby certify that under requirements of P.A. 74, Michigan P.A. of 1970, the corner points mentioned in lines 1 and 2 above were in conformance with regulations and rules therefore as required in the current manual of survey instructions of the United States Department of the Interior, Bureau of Land Management or by a decree of a Court of Law and/or that the corner points mentioned in lines 3, 4 and 5 above were in conformance with the rules of the Michigan Board of Land Surveyors or by a Decree of a Court of Law; established, re-established, monumented, re-monumented, recovered, found as expressed below.

1	A	B	C	D	E	F	G	H	I	J	K	L	M
2		6	5	4	3	2	1						
3													
4		7	8	9	10	11	12						
5													
6		18	17	16	15	14	13						
7													
8		19	20	21	22	23	24						
9													
10		30	29	28	27	26	25						
11													
12		31	32	33	34	35	36						
13													


**NOTE: Not more than 4 corners, all in the same town and range, may be recorded on this certificate.**

A. Description of original monument and accessories and/or subsequent restoration:  
L-13  
GLO-Britain - 1832 East on South side of Section 36  
23.50 to Grand River and set meander post  
GLO-Mullett - 1837 West on South side of Section 36, 40.00 set QR Sec. post  
45.40 to Grand River and set post  
54.50 over River to old post on left bank  
North line of Section 1, T7N, R16W is shown on Borck's Supervisor's Plat No. 1 - 1930

**P.A. 345 OTTAWA COUNTY**  
**PREP APPROVED 6-15-98**  
*YDZ*

B. Description of corner evidence found and/or method applied in restoring or reestablishing corner:  
L-13  
Found no field evidence or survey record that original L-13 post had ever been located.  
Re-established the North and South position of the GLO MP on the West side of the Grand River by measuring the platted distance of 343' North of a found concrete monument on the East line of Lot 17, Block 22 of Borck's Supervisor's Plat at the extension of the South line of Lake Avenue.  
Re-established the East and West position of the GLO MP by proportionate measure between K-13 and M-13.  
Re-established L-13 on the Section line between the GLO MP and M-13 at proportionate distance between K-13 and M-13.  
Set an Ottawa County Remonumentation iron and cap at L-13 and is accepted as a careful and faithful re-establishment of the position of the original corner.  
See sketch on back.

C. Description of monument for corner and accessories established to perpetuate locating the position of the corner:  
L-13  
Ottawa County Remonumentation iron and cap  
Azimuth= Michigan State Plane Grid Direction  
Remonumentation tag in North side 10" Poplar 229° 47' 177.96  
Remonumentation tag in North 16" Willow 297° 19' 396.66  
Remonumentation tag in South Twin 20" Maple 304° 17' 587.13  
Remonumentation tag in Southeast 12" Poplar 312° 30' 877.62  
L-1 T7N, R16W 90° 45' 67.62

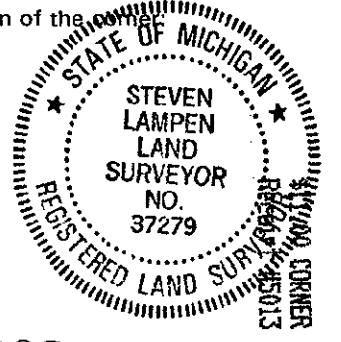

Signed by Steven Lampen Date JULY 20, 1998  
Surveyor's Michigan License No. 37279

FORM APPROVED BY MICHIGAN STATE BOARD OF LAND SURVEYORS, JAN. 28, 11  
REVISED MAY 14, 15  
REVISED JAN., 15  
ADAPTED FOR WORD PROCESSING MARCH, 15

SURVEY &  
REMONUMENTATION

DEC 01 1998

SECTION

