

FEB 24 2000

RECORDED

99 SEP 23 PM 3: 21

SECTION

OTTAWA COUNTY REMONUMENTATION
LAND CORNER RECORDATION CERTIFICATE
Filing Requirement of Act 74, Mich. P.A. 1970

For corners in

Sam Schmitt
REGISTER OF DEEDS
OTTAWA COUNTY, MI

<u>Ottawa</u> (County)	Located In: Spring Lake Township	Corner Code # M-1
1. Public Land Survey	T <u>8N</u> R <u>16W</u>	<u>NE corner</u> <u>Section 1</u>
	T <u> </u> R <u> </u>	<u> </u>
	T <u> </u> R <u> </u>	<u> </u>
	T <u> </u> R <u> </u>	<u> </u>
2. Property Controlling in Section	S <u> </u> T <u> </u> R <u> </u>	<u> </u>
	S <u> </u> T <u> </u> R <u> </u>	<u> </u>
3. Miscellaneous Property in Sec.	S <u> </u> T <u> </u> R <u> </u>	<u> </u>
	S <u> </u> T <u> </u> R <u> </u>	<u> </u>

Register of Deeds Stamp & File Number

4. Lot No. _____, Recorded Plat _____
5. Private Claims _____

I, Carl P. Englert, in a field survey on 6/10, 19 99 do hereby state that under requirements of P.A. 74, Michigan P.A. of 1970, the corner points mentioned in lines 1 and 2 above were in conformance with regulations and rules therefore as required in the current manual of survey instructions of the United States Department of the Interior, Bureau of Land Management or by a decree of a Court of Law and /or that the corner points mentioned in lines 3, 4 and 5 above were in conformance with the rules of the Michigan Board of Land Surveyors or by a Decree of a Court of Law; established, re-established, monumented, recovered, found as expressed below:

NOTE: Not more than 2 corners, all in the same town and range, may be recorded on this certificate.

1	A	B	C	D	E	F	G	H	I	J	K	L
2	6		5		4		3		2		1	
3												
4	7		8		9		10		11		12	
5												
6	18		17		16		15		14		13	
7												
8	19		20		21		22		23		24	
9												
10	30		29		28		27		26		25	
11												
12	31		32		33		34		35		36	
13												

A. Description of original monument and accessories and/or subsequent restoration:

M-1 Corner to Towns 8 and 9N, Range 15 and 16 W
 John Mullett April, 1837 LCRC Liber 1056, Page 573
 Beech 9 Inch N13E 25 links Muskegon Co. Records J. Clapp 1975
 Beech 16 Inch S10E 48 links Found Iron Pipe
 20" Oak SW 38.67'
 12" Oak NE 30.59'
 See Other Side 8" Pine NW 59.02' Triple 8" Cherry SE
 18" Oak NE 75.74' 72.40'

B. Description of corner evidence found and/or method applied in restoring or reestablishing corner:

M-1 Found 4" Harrison Cast Iron Monument with top broken off
 4' West of centerline of asphalt pavement 0.6' below grade
 Found Power Pole S45°E 42.73', Found Guy Pole S15°W 36.16'
 Found 12" Oak N35°W 54.29', Found Twin Oak N35°E 54.62'


Accepted as a careful and faithful perpetuation of the original position of the corner.

C. Description of monument for corner and accessories established to perpetuate locating the position of the corner:

M-1 4" Harrison Cast Iron Monument
 O.C. Remon Nail and Tag in W Side Guy Pole S24°W 36.07'
 O.C. Remon Nail and Tag in SW Side P.P. S42°E 42.73'
 O.C. Remon Nail and Tag in SE Side 28" Oak N46°E 54.42'
 O.C. Remon Nail and Tag in SW Side 26" Oak N50°W 60.73'
 Found 1/2" Capped Iron West 33.02'

Signed by Carl P. Englert
Surveyor's Michigan License No. 18987

Date 9/13/1999

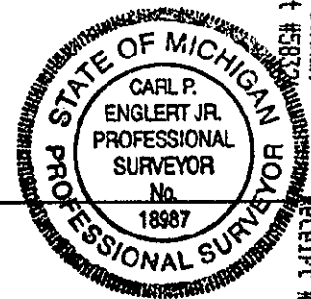

\$11.00 CORNER
Receipt #5832

FEB 24 2000

SECTION

M-1 T8N, R15W

LCRC Liber 1118, Page 935 Muskegon Co. Records
Found 1/2" Rod
ENE 30.67' 14" Oak
SW 38.69' 20" Oak
NW 59.25' 10" Pine Englert 1977

Liber 1240, Page 540, Muskegon Co. Records
Found 4" Cast Iron Monument
N68°E 30.67' 16" Oak
N37°E 75.74' 20" Oak
N36°W 59.20' 10" Pine
S24°W 36.20' Guy Pole
S42°E 42.75' P.P. Lewandoski 1982

LCRC Liber 3, Page 226 Ottawa Co. Records
Replaced Iron Pipe with Cast Iron Monument
Inscribed "Ottawa County Section Corner"
20" Oak SW 38.70'
8" Pine NW 59.21'
12" Oak NE 30.59'
18" Oak NE 75.69'
Power Pole SE 42.27'
30" Oak SW 103.16' Joiner 1977

LCRC Liber 6, Page 192, Ottawa Co. Records
Broken Cast Iron Monument
Nail in SW Side P.P. S45°E 42.73'
Nail in W Side Guy Pole S15°W 36.16'
P.K. Nail in NE Side 12" Oak N35°W 54.29'
P.K. Nail in SE Side 14"-22" Twin Oak N35°E 54.62'
Nail in face of 16" Oak N70°E 30.65'

Chris Marschall 1991