SURVEY & REMONUMENTATION

APR 2 4 1995

COMMISSION

OTTAWA COUNTY REMONUMENTATION

LAND CORNER RECORDATION CERTIFICATE

Filing Requirement of Act 74, Mich. P.A. 1970

RECORDED

94 DEC 15 AM 11:46

REGISTER OF DEEDS
OTTAWA COUNTY, MI

For corners in

Ottawa
(County)

	Located In:	Corner Code #
1. Public Land Survey	T 8N R 16W	M-2, E¼ Cor.
	T ___ R ___	Section 1
	T ___ R ___	Spring Lake Twp.
	T ___ R ___	
2. Property Controlling	S ___ T ___ R ___	
in Section	S ___ T ___ R ___	
3. Miscellaneous	S ___ T ___ R ___	
Property in Sec.	S ___ T ___ R ___	

Register of Deeds Stamp & File Number

4. Lot No. _____, Recorded Plat _____
5. Private Claims _____

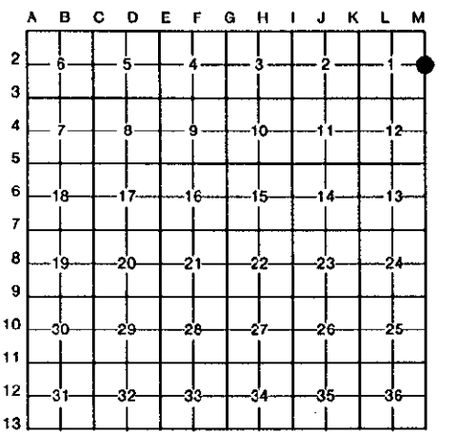

I, THOMAS E. JOINER in a field survey on 11-29-, 19 94, do hereby certify that under requirements of P.A. 74, Michigan P.A. of 1970, the corner points mentioned in lines 1 and 2 above were in conformance with regulations and rules therefore as required in the current manual of survey instructions of the United States Department of the Interior, Bureau of Land Management or by a decree of a Court of Law and/or that the corner points mentioned in lines 3, 4 and 5 above were in conformance with the rules of the Michigan Board of Land Surveyors or by a Decree of a Court of Law; established, re-established, monumented, re-monumented, recovered, found as expressed below:

NOTE: Not more than 4 corners, all in the same town and range, may be recorded on this certificate.

A. Description of original monument and accessories and/or subsequent restoration:

1837
Post Set by John Mullet, D.S.
S 04°W 152 24" Pine
N 11°W 120 24" Pine

Liber 1, Pg. 595, 08-21-72
Found Pinched Iron Pipe
NW 67.13 Power Pole
NE 45.19 40" Oak
SE 39.70 Street Sign
SE 51.85 12" Oak
SW 58.25 22" Oak

Liber 3, Pag. 219, 12-21-77
Replaced Pipe w/Cast Iron Mon.
NE 45.10 40" Oak
NW 66.81 Power Pole
SW 58.09 22" Oak
SE 67.88 Power Pole

Liber 6, Pg. 191, 12-18-91
Found Cast Iron Monument
N 55°E 46.39 PK NW side 36" Oak
S 70°E 88.96 PK N side 16" Oak
S 45°W 54.22 PK SE side 14" Oak
N 60°W 69.58 PK S side 28" Oak
S 40°E 50.56 Top Center of Fire Hyd
West 1' ℄ N-S Bit. Pavement
West 2' PK Nail in Pavement
North 2' PK Nail in Pavement

B. Description of corner evidence found and/or method applied in restoring or reestablishing corner:

Found Cast Iron Monument in Monument Box, 5" Below Bottom of Box, Center of Monument was directly below edge of Monument Box and accepted as a careful and faithful perpetuation of the position of the original corner.

Liber 1, Pg. 595, 08-21-72
NE 45.19 40" Oak
SW 58.25 22" Oak

Liber 3, Pg. 219, 12-21-77
NE 45.10 40" Oak
NW 66.81 Power Pole
SW 58.09 22" Oak
SE 67.88 Power Pole

Liber 6, Pg. 191, 12-18-91
N 55°E 46.39 PK NW side 36" Oak
S 70°E 88.96 PK N side 16" Oak
S 45°W 54.22 PK SE side 14" Oak
N 60°W 69.58 PK S side 28" Oak
S 40°E 50.56 Top Center of Fire Hydrant
West 1' ℄ N-S Bit. Pavement

C. Description of monument for corner and accessories established to perpetuate locating the position of the corner:

Raised Cast Iron Monument inside of Cast Iron Monument Box repositioned by materials testing.

O.C. Remon. Tag & Nail in NW side 41" Oak	Az. 62°	46.39
℄ Top Operating Nut on Hydrant	Az. 146°	50.56
O.C. Remon. Tag & Nail in SE side 30" Oak	Az. 241°	59.10
O.C. Remon. Tag & Nail in S side 29" Oak	Az. 308°	69.58

STATE of MICHIGAN
THOMAS E. JOINER
LAND SURVEYOR
No. 18435
Registered Land Surveyor

P.A. 345 OTTAWA COUNTY

PEER APPROVED 12/12/94 Rodney D. Rodewald

Signed by Thomas E. Joiner Date 12-12-94

Surveyor's Michigan License No. 18435

FORM APPROVED BY MICHIGAN STATE BOARD OF LAND SURVEYORS, JAN. 28, 1971
REVISED MAY 14, 1975
REVISED JAN., 1983