

1828

COMMISSION

OTTAWA COUNTY REMONUMENTATION
LAND CORNER RECORDATION CERTIFICATE
Filing Requirement of Act 74, Mich. P.A. 1970

RECORDED
93 DEC 16 PM 1:01
Phyllis Carlsson
REGISTER OF DEEDS
OTTAWA COUNTY, MI

For corners in

Ottawa (County)	Located In:	Corner Code #
1. Public Land Survey	T <u>8N</u> R <u>16W</u>	M-5, NE corner
	T _____ R _____	Section 13
	T _____ R _____	_____
	T _____ R _____	_____
2. Property Controlling in Section	S _____ T _____ R _____	_____
	S _____ T _____ R _____	_____
3. Miscellaneous Property in Sec.	S _____ T _____ R _____	_____
	S _____ T _____ R _____	_____

Register of Deeds Stamp & File Number

4. Lot No. _____, Recorded Plat _____
5. Private Claims _____

I, THOMAS E. JOINER, in a field survey on 8-27- 19 93, do hereby certify that under requirements of P.A. 74, Michigan P.A. of 1970, the corner points mentioned in lines 1 and 2 above were in conformance with regulations and rules therefore as required in the current manual of survey instructions of the United States Department of the Interior, Bureau of Land Management or by a decree of a Court of Law and/or that the corner points mentioned in lines 3, 4 and 5 above were in conformance with the rules of the Michigan Board of Land Surveyors or by a Decree of a Court of Law; established, re-established, monumented, re-monumented, recovered, found as expressed below:

	A	B	C	D	E	F	G	H	I	J	K	L	M
2	6	5	4	3	2	1							
3													
4	7	8	9	10	11	12							
5													
6	18	17	16	15	14	13							
7													
8	19	20	21	22	23	24							
9													
10	30	29	28	27	26	25							
11													
12	31	32	33	34	35	36							
13													

NOTE: Not more than 4 corners, all in the same town and range, may be recorded on this certificate.


A. Description of original monument and accessories and/or subsequent restoration:

- | | |
|----------------------|-------------------------------|
| T-Iron 1960 T & H | Cast Iron Monument In Box |
| S.E. 44.1 Tele. Pole | Liber 2, Pg. 223 6-25-73 |
| N.E. 51.7 Tele. Pole | N.E. 51.50 Tele. Pole |
| N.E. 90.0 Tele. Pole | N.W. 38.70 12" Oak |
| | S.E. 43.98 Tele. Pole |
| | N.E. 83.30 S.W. Corner Church |

B. Description of corner evidence found and/or method applied in restoring or reestablishing corner:

Found cast iron monument and accepted as a careful and faithful perpetuation of the position of the original corner.

- N.E. 83.30 S.W. Corner Church
- N.W. 38.70 12" Oak
- S.E. 43.98 Tele. Pole
- N.E. 51.50 Tele. Pole

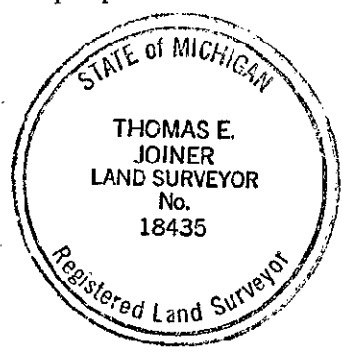

C. Description of monument for corner and accessories established to perpetuate locating the position of the corner:

Ottawa County Remon cap over existing cast iron monument

- | | | |
|---|------------------|--------|
| O.C. Remon tag & nail in West side power pole | AZ. 133° 47' 00" | 52.70 |
| House #17581 N.E. corner conc. block basement | AZ. 204° 08' 00" | 128.52 |
| House #17611 S.E. corner conc. block basement | AZ. 309° 11' 00" | 113.44 |
| Conc. Block Church N.E. corner | AZ. 46° 02' 00" | 83.30 |

Signed by Thomas E. Joiner Date 8-31-93
Surveyor's Michigan License No. 18435