

1983

RECORDED

93 DEC 16 PM 1:01

OTTAWA COUNTY REMONUMENTATION
LAND CORNER RECORDATION CERTIFICATE

Filing Requirement of Act 74, Mich. P.A. 1970

Phyllis Carlsson
REGISTER OF DEEDS
OTTAWA COUNTY, MI

For corners in COMMISSION

Ottawa (County)	Located In:	Corner Code #
1. Public Land Survey	T <u>8N</u> R <u>16W</u>	M-6, E $\frac{1}{2}$ Corner Section 13
	T _____ R _____	_____
	T _____ R _____	_____
	T _____ R _____	_____
2. Property Controlling in Section	S _____ T _____ R _____	_____
	S _____ T _____ R _____	_____
3. Miscellaneous Property in Sec.	S _____ T _____ R _____	_____
	S _____ T _____ R _____	_____

Register of Deeds Stamp & File Number

- 4. Lot No. _____, Recorded Plat _____
- 5. Private Claims _____

	A	B	C	D	E	F	G	H	I	J	K	L	M
2	6	5	4	3	2	1							
3													
4	7	8	9	10	11	12							
5													
6	18	17	16	15	14	13							
7													
8	19	20	21	22	23	24							
9													
10	30	29	28	27	26	25							
11													
12	31	32	33	34	35	36							
13													

I, THOMAS E. JOINER in a field survey on 8-27-1993
do hereby certify that under requirements of P.A. 74, Michigan P.A. of 1970, the corner points mentioned
in lines 1 and 2 above were in conformance with regulations and rules therefore as required in the
current manual of survey instructions of the United States Department of the Interior, Bureau of Land
Management or by a decree of a Court of Law and/or that the corner points mentioned in lines 3, 4 and 5
above were in conformance with the rules of the Michigan Board of Land Surveyors or by a Decree of a
Court of Law; established, re-established, monumented, re-monumented, recovered, found as
expressed below:

NOTE: Not more than 4 corners, all in the same town and range, may be recorded on this certificate.


A. Description of original monument and accessories and/or subsequent restoration:

- | | |
|------------------------------------|---------------------------|
| Iron 1964 T & H | Cast Iron Monument In Box |
| N.W. 46.30 8" White Oak | Liber 2, Pg. 223 6-25-73 |
| N.E. 37.30 24" Maple | N.W. 54.39 10" Oak |
| West 16.90 N.E. Corner Conc. Drive | N.E. 38.59 38" Maple |
| | S.E. 65.02 28" Oak |

B. Description of corner evidence found and/or method applied in restoring or reestablishing corner:

Found cast iron monument and accepted as a careful and faithful perpetuation of the position of the original corner.

- S.E. 65.02 28" Oak
- N.E. 38.59 38" Maple
- N.W. 54.39 10" Maple

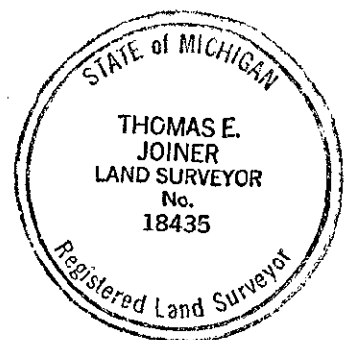

C. Description of monument for corner and accessories established to perpetuate locating the position of the corner:

Ottawa County Remonument Cap Over Existing Cast Iron Monument

- | | | |
|--|------------------|-------|
| O.C. Remon tag & nail in S.E. side of 38" Oak | AZ. 149° 29' 00" | 65.31 |
| O.C. Remon tag & nail in S.E. side of 22" Maple | AZ. 22° 58' 00" | 70.87 |
| O.C. Remon tag & nail in N.E. side of 18" Oak | AZ. 307° 07' 00" | 54.80 |
| N.E. corner of concrete block garage, House #17171 | AZ. 271° 10' 00" | 93.58 |

Signed by Thomas E. Joiner Date 8-31-93
Surveyor's Michigan License No. 18435