

OTTAWA COUNTY REMONUMENTATION
LAND CORNER RECORDATION CERTIFICATE
Filing Requirement of Act 74, Mich. P.A. 1970

Phyllis Robinson
REGISTER OF DEEDS
OTTAWA COUNTY, MI

For corners in

COMMISSION

Ottawa (County)	Located In:	Corner Code #
1. Public Land Survey	T <u>8N</u> R <u>16W</u>	<u>M-7, NE corner</u> <u>Section 24</u>
	T _____ R _____	_____
	T _____ R _____	_____
	T _____ R _____	_____
2. Property Controlling in Section	S _____ T _____ R _____	_____
	S _____ T _____ R _____	_____
3. Miscellaneous Property in Sec.	S _____ T _____ R _____	_____
	S _____ T _____ R _____	_____
4. Lot No. _____, Recorded Plat _____		
5. Private Claims _____		

Register of Deeds Stamp & File Number

I, THOMAS E. JOINER in a field survey on 8-27-93, 1993
do hereby certify that under requirements of P.A. 74, Michigan P.A. of 1970, the corner points mentioned
in lines 1 and 2 above were in conformance with regulations and rules therefore as required in the
current manual of survey instructions of the United States Department of the Interior, Bureau of Land
Management or by a decree of a Court of Law and/or that the corner points mentioned in lines 3, 4 and 5
above were in conformance with the rules of the Michigan Board of Land Surveyors or by a Decree of a
Court of Law; established, re-established, monumented, re-monumented, recovered, found as
expressed below:

	A	B	C	D	E	F	G	H	I	J	K	L	A
2	6	5	4	3	2	1							
3													
4	7	8	9	10	11	12							
5													
6	18	17	16	15	14	13							
7													
8	19	20	21	22	23	24							
9													
10	30	29	28	27	26	25							
11													
12	31	32	33	34	35	36							
13													

NOTE: Not more than 4 corners, all in the same town and range, may be recorded on this certificate.


A. Description of original monument and accessories and/or subsequent restoration:

Gas Pipe 1958 T & H	1" Iron In Monument Box
S 17° E 38.80 12" Syc	Liber 3, Pg. 37 3-3-76
N 66° E 74.4 29" Cherry	SW 70.53 Powerpole
S 18° E 39.7 32" Syc	NW 59.59 Powerpole
N 35° W 59.87 Powerpole	SE 51.09 Powerpole

B. Description of corner evidence found and/or method applied in restoring or reestablishing corner:

Found 1" Monument Box and accepted as a careful and faithful perpetuation of the position of the original corner.

SW 70.53 Powerpole
 NW 59.59 Powerpole
 SE 51.02 Powerpole

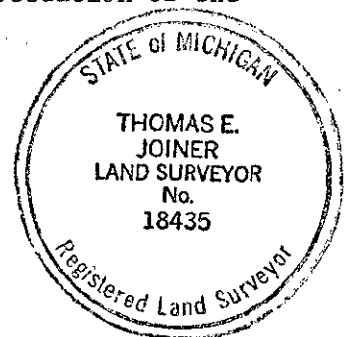

C. Description of monument for corner and accessories established to perpetuate locating the position of the corner:

Ottawa County Remon cap over existing 1" Iron

O.C. Remon tag & nail in East side of Powerpole	AZ.	209°	05'	00"	70.75
O.C. Remon tag & nail in East side of Powerpole	AZ.	325°	47'	00"	59.58
O.C. Remon tag & nail in West side of Powerpole	AZ.	137°	35'	00"	51.18
Centerline Hydrant Operating Nut	AZ.	22°	22'	00"	86.33

Signed by Thomas E. Joiner Date 8-31-93
 Surveyor's Michigan License No. 18435