

RECORDED

RECORDED

93 DEC 16 PM 1:01

OTTAWA COUNTY REMONUMENTATION  
LAND CORNER RECORDATION CERTIFICATE  
Filing Requirement of Act 74, Mich. P.A. 1970

For corners in OTTAWA COUNTY

*Daphnia Robinson*  
REGISTER OF DEEDS  
OTTAWA COUNTY, MI

Ottawa (County)	Located In:	Corner Code #
1. Public Land Survey	T 8N R 16W	M-9, S.E. corner
	T R	Section 24
	T R	
	T R	
2. Property Controlling in Section	S T R	
	S T R	
3. Miscellaneous Property in Sec.	S T R	
	S T R	

Register of Deeds Stamp & File Number

4. Lot No. \_\_\_\_\_, Recorded Plat \_\_\_\_\_  
5. Private Claims \_\_\_\_\_

	A	B	C	D	E	F	G	H	I	J	K	L	M
2	6	5	4	3	2	1							
3													
4	7	8	9	10	11	12							
5													
6	18	17	16	15	14	13							
7													
8	19	20	21	22	23	24							
9													
10	30	29	28	27	26	25							
11													
12	31	32	33	34	35	36							
13													

I, THOMAS E. JOINER in a field survey on 11-3-1993, do hereby certify that under requirements of P.A. 74, Michigan P.A. of 1970, the corner points mentioned in lines 1 and 2 above were in conformance with regulations and rules therefore as required in the current manual of survey instructions of the United States Department of the Interior, Bureau of Land Management or by a decree of a Court of Law and/or that the corner points mentioned in lines 3, 4 and 5 above were in conformance with the rules of the Michigan Board of Land Surveyors or by a Decree of a Court of Law; established, re-established, monumented, re-monumented, recovered, found as expressed below:

NOTE: Not more than 4 corners, all in the same town and range, may be recorded on this certificate.


A. Description of original monument and accessories and/or subsequent restoration:

Found 3/4" Rod In Monument Box	Set Cast Iron Monument Liber 5, Pg. 93
S.E. 58.75 Powerpole	N.W. 53.37 Hydrant
S.W. 67.70 Powerpole	N.E. 81.69 12" Spruce
N.E. 81.53 12" Spruce	E.N.E. 92.31 Tele. Pole
N.W. 46.70 30" Maple	S.E. 58.81 Powerpole

B. Description of corner evidence found and/or method applied in restoring or reestablishing corner:

Found cast iron monument and accepted as a careful and faithful perpetuation of the position of the original corner.

N.W. 53.37 Hydrant  
E.N.E. 92.31 Tele. Pole  
S.E. 58.81 Powerpole

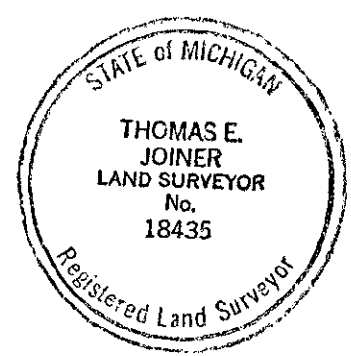

C. Description of monument for corner and accessories established to perpetuate locating the position of the corner:

Cast Iron Monument

O.C. Remon tag & nail South side of 18" White Pine	AZ. 26° 22' 24"	81.25
O.C. Remon tag & nail West side of powerpole	AZ. 145° 12' 06"	58.80
O.C. Remon tag & nail East side of powerpole	AZ. 226° 02' 18"	67.65
C <sub>L</sub> Hydrant	AZ. 306° 16' 18"	53.11

Signed by Thomas E. Joiner Date 11-19-93  
Surveyor's Michigan License No. 18435