SURVEY & REMONUMENTATION

APR 05 1996

COMMISSION

OTTAWA COUNTY REMONUMENTATION

LAND CORNER RECORDATION CERTIFICATE

Filing Requirement of Act 74, Mich. P.A. 1970

RECORDED

95 NOV 29 PM 1:38

REGISTER OF DEEDS
OTTAWA COUNTY, MI

Register of Deeds Stamp & File Number

For corners in Ottawa (County)

	Located In:	Corner Code #
1. Public Land Survey	T 8N R 16W	M-10, E¼ Corner
	T ___ R ___	Section 25
	T ___ R ___	Spring Lake Twp
	T ___ R ___	
2. Property Controlling	S ___ T ___ R ___	
in Section	S ___ T ___ R ___	
3. Miscellaneous	S ___ T ___ R ___	
Property in Sec.	S ___ T ___ R ___	

4. Lot No. _____, Recorded Plat _____
5. Private Claims _____

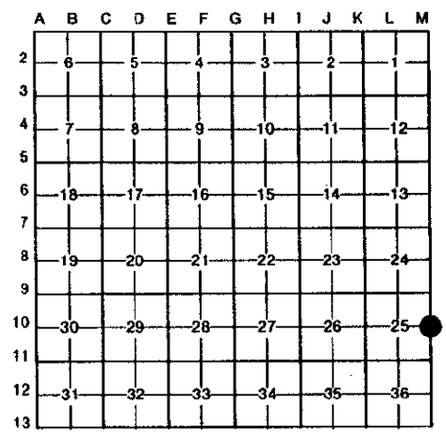

I, Thomas E. Joiner, in a field survey on 11-7-, 19 95, do hereby certify that under requirements of P.A. 74, Michigan P.A. of 1970, the corner points mentioned in lines 1 and 2 above were in conformance with regulations and rules therefore as required in the current manual of survey instructions of the United States Department of the Interior, Bureau of Land Management or by a decree of a Court of Law and/or that the corner points mentioned in lines 3, 4 and 5 above were in conformance with the rules of the Michigan Board of Land Surveyors or by a Decree of a Court of Law; established, re-established, monumented, re-monumented, recovered, found as expressed below:

NOTE: Not more than 4 corners, all in the same town and range, may be recorded on this certificate.

A. Description of original monument and accessories and/or subsequent restoration:

1837
Post Set By J. Mullelt
S 21°W 61lks 12" Ash

Liber 2, Page 399 11-30-73
Found 5/8 Rod
W 32.80 32" Maple
SSE 71.36 22" Oak
SE 51.25 16" Pepperidge

B. Description of corner evidence found and/or method applied in restoring or reestablishing corner:

Found Cast Iron Monument in Monument Box and accepted as a careful and faithful perpetuation of the position of the original corner.
Liber 2, Page 399
W 32.80 32" Maple
SE 51.25 16" Pepperidge

P.A. 345 OTTAWA COUNTY
PEER APPROVED 11/20/95
Rodney D. Nederveld PDM

C. Description of monument for corner and accessories established to perpetuate locating the position of the corner:

Cast Iron Monument

O.C. Remon Tag & Nail in S side of 33" Maple	AZ	280°	32.71
O.C. Remon Tag & Nail in NE side of 20" Pepperidge	AZ	122°	51.56
O.C. Remon Tag & Nail in SE side of 10" Elm	AZ	212°	72.0
℄ Top operating Bolt on Hydrant	AZ	121°	35.49

STATE of MICHIGAN
THOMAS E. JOINER
LAND SURVEYOR
No. 18435
Registered Land Surveyor

Signed by Thomas E. Joiner Date 11-16-95

Surveyor's Michigan License No. 18435

FORM APPROVED BY MICHIGAN STATE BOARD OF LAND SURVEYORS, JAN. 28, 1971
REVISED MAY 14, 1975
REVISED JAN., 1983