

**SURVEY &
REMONUMENTATION**

APR 05 1996

COMMISSION

**OTTAWA COUNTY REMONUMENTATION
LAND CORNER RECORDATION CERTIFICATE
Filing Requirement of Act 74, Mich. P.A. 1970**

For corners in

| Ottawa (County) | Located In: | Corner Code # |
|---------------------------------------|---------------------------|---|
| 1. Public Land Survey | T <u>8N</u> R <u>16 W</u> | M-12, E $\frac{1}{4}$ corner Section 36 Spring Lake Twp |
| | T ___ R ___ | _____ |
| | T ___ R ___ | _____ |
| | T ___ R ___ | _____ |
| 2. Property Controlling in Section | S ___ T ___ R ___ | _____ |
| | S ___ T ___ R ___ | _____ |
| 3. Miscellaneous Property in Sec. | S ___ T ___ R ___ | _____ |
| | S ___ T ___ R ___ | _____ |

RECORDED

95 NOV 29 PM 1:33

R. J. ...
REGISTER OF DEEDS
OTTAWA COUNTY, MI

Register of Deeds Stamp & File Number

4. Lot No. _____, Recorded Plat _____
5. Private Claims _____

| | A | B | C | D | E | F | G | H | I | J | K | L | M |
|----|----|----|----|----|----|----|---|---|---|---|---|---|---|
| 2 | 6 | 5 | 4 | 3 | 2 | 1 | | | | | | | |
| 3 | | | | | | | | | | | | | |
| 4 | 7 | 8 | 9 | 10 | 11 | 12 | | | | | | | |
| 5 | | | | | | | | | | | | | |
| 6 | 18 | 17 | 16 | 15 | 14 | 13 | | | | | | | |
| 7 | | | | | | | | | | | | | |
| 8 | 19 | 20 | 21 | 22 | 23 | 24 | | | | | | | |
| 9 | | | | | | | | | | | | | |
| 10 | 30 | 29 | 28 | 27 | 26 | 25 | | | | | | | |
| 11 | | | | | | | | | | | | | |
| 12 | 31 | 32 | 33 | 34 | 35 | 36 | | | | | | | |
| 13 | | | | | | | | | | | | | |

I, THOMAS E. JOINER, in a field survey on 11-9-95, 1995, do hereby certify that under requirements of P.A. 74, Michigan P.A. of 1970, the corner points mentioned in lines 1 and 2 above were in conformance with regulations and rules therefore as required in the current manual of survey instructions of the United States Department of the Interior, Bureau of Land Management or by a decree of a Court of Law and/or that the corner points mentioned in lines 3, 4 and 5 above were in conformance with the rules of the Michigan Board of Land Surveyors or by a Decree of a Court of Law; established, re-established, monumented, re-monumented, recovered, found as expressed below:

NOTE: Not more than 4 corners, all in the same town and range, may be recorded on this certificate.

A. Description of original monument and accessories and/or subsequent restoration:

| | | |
|----------------------------------|------------------|------------|
| 05-09-1832 | Liber 2 Page 635 | 10-9-74 |
| Post Set By Calvin Britain, D.S. | Found Angle Iron | |
| N 40° W 22 10" Beech | East 33.1 | Fence Post |
| S 55° W 20 10" Hemlock | NE 34.69 | 14" Willow |

B. Description of corner evidence found and/or method applied in restoring or reestablishing corner:

Found Cast Iron Monument in Monument Box and accepted as a careful and faithful perpetuation of the position of the original corner.


Liber 2, Page 635
East 33.1 Fence Post
NE 34.69 14" Willow

P.A. 345 OTTAWA COUNTY
PEER APPROVED 11/20/95
Richard P. Hedwood
GOT

C. Description of monument for corner and accessories established to perpetuate locating the position of the corner:

Cast Iron Monument

| | | | |
|----------------------------------|---------------|---------|--------|
| O.C. Remon Tag & Nail in N side | 15" Red Pine | AZ 88° | 44.96 |
| O.C. Remon Tag & Nail in NW side | 8" Apple | AZ 35° | 84.34 |
| O.C. Remon Tag & Nail in S side | 20" Oak | AZ 115° | 90.38 |
| O.C. Remon Tag & Nail in E side | of Power Pole | AZ 354° | 172.03 |

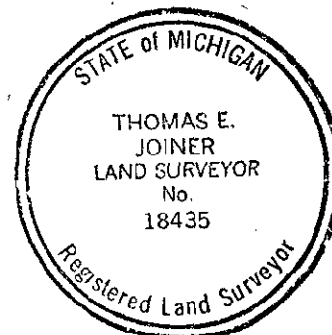

Signed by Thomas E. Joiner Date 11-16-95
Surveyor's Michigan License No. 18435