

OTTAWA COUNTY REMONUMENTATION

LAND CORNER RECORDATION CERTIFICATE
Filing Requirement of Act 74, Mich. P.A. 1970

For corners in

Ottawa

(County)

Located In:

Corner Code #

Chester Twp.

- | | | |
|------------------------------------|--|---------------|
| 1. Public Land Survey | T <u>9</u> N R <u>13</u> W | A-3, S W cor. |
| | T <u> </u> R <u> </u> | Sec. 6 |
| | T <u> </u> R <u> </u> | |
| | T <u> </u> R <u> </u> | |
| 2. Property Controlling in Section | S <u> </u> T <u> </u> R <u> </u> | |
| | S <u> </u> T <u> </u> R <u> </u> | |
| 3. Miscellaneous Property in Sec. | S <u> </u> T <u> </u> R <u> </u> | |
| | S <u> </u> T <u> </u> R <u> </u> | |

4. Lot No. _____, Recorded Plat _____
5. Private Claims _____

I, Randal D. Feenstra, in a field survey on Feb. 5, 19 96 do hereby state that under requirements of P.A. 74, Michigan P.A. of 1970, the corner points mentioned in lines 1 and 2 above were in conformance with regulations and rules therefore as required in the current manual of survey instructions of the United States Department of the Interior, Bureau of Land Management or by a decree of a Court of Law and/or that the corner points mentioned in lines 3, 4 and 5 above were in conformance with the rules of the Michigan Board of Land Surveyors or by a Decree of a Court of Law; established, re-established, monumented, recovered, found as expressed below:

NOTE: Not more than 2 corners, all in the same town and range, may be recorded on this certificate.

RECORDED

Type 96 DEC 17 AM 10:42

Randy D. Feenstra
REGISTER OF DEEDS
OTTAWA COUNTY, MI

Register of Deeds Stamp & File Number

1	A	B	C	D	E	F	G	H	I	J	K	L	M
2		6		5		4		3		2		1	
3													
4		7		8		9		10		11		12	
5													
6		10		17		16		15		14		13	
7													
8		19		20		21		22		23		24	
9													
10		30		29		28		27		26		25	
11													
12		31		32		33		34		35		36	
13													

A. Description of original monument and accessories and/or subsequent restoration:

G.L.O. (1837)	L-5, P-50, 1983	
John Mullet	Cast Iron Monument	
Post	T. Pole	SW 64.00'
18" Sugar Maple N48°W 21 lks	18" Catalpa	SW 96.15'
14" Hemlock S65°W 35 lks	P. Pole	SE 99.30'
	T. Pole	N 32.32'

P.A. 345 OTTAWA COUNTY
PEER APPROVED 11-11-96

B. Description of corner evidence found and/or method applied in restoring or reestablishing corner:
A-3 Found: Cast Iron Monument in box

R.D.F.


Nail NW side T. Pole	S 60°W	62.93'
Nail NW side P. Pole	S 31°E	99.32'
24" Catalpa WSW		97'

Accepted as a careful and faithful perpetuation of the position of the original corner.

C. Description of monument for corner and accessories established to perpetuate locating the position of the corner:

A-3 Cast Iron Monument in Box

Ottawa County Remon Nail & Tag in W side T. Pole	N	44.90'
Ottawa County Remon Nail & Tag in NW side T. Pole	S 60°W	62.93'
Ottawa County Remon nail & Tag in NE side P. Pole	S 31°E	99.78'
Centerline Metal Pipe Fence Post	S 37°W	48.34'

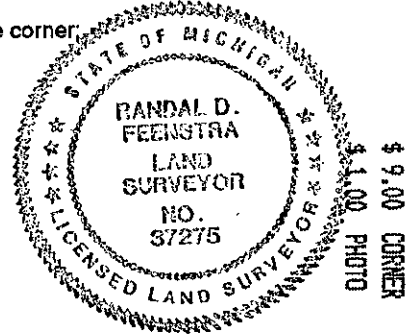

Signed by *Randal D. Feenstra*
Surveyor's Michigan License No. 37275

Date February 5, 1996