

RF

FEB 24 2000

OTTAWA COUNTY REMONUMENTATION

RECORDED

99 JUL 30 PM 12:26

LAND CORNER RECORDATION CERTIFICATE
Filing Requirement of Act 74, Mich. P.A. 1970

Randy Schmitt
REGISTER OF DEEDS
OTTAWA COUNTY, MI

SECTION

For corners in
Ottawa

Located In:	Corner Code #
Chester Twp.	A-4 W 1/4 Cor.
9N 13W	Sec. 7
T___ R___	_____
T___ R___	_____
T___ R___	_____
T___ R___	_____
S___ T___ R___	_____
S___ T___ R___	_____
S___ T___ R___	_____
S___ T___ R___	_____

1. Public Land Survey

2. Property Controlling
in Section

3. Miscellaneous
Property in Sec.

4. Lot No. _____, Recorded Plat _____
5. Private Claims _____

Randal D. Feenstra March 22 99

I, _____, in a field survey on _____, 19____ do hereby state that under requirements of P.A. 74, Michigan P.A. of 1970, the corner points mentioned in lines 1 and 2 above were in conformance with regulations and rules therefore as required in the current manual of survey instructions of the United States Department of the Interior, Bureau of Land Management or by a decree of a Court of Law and/or that the corner points mentioned in lines 3, 4 and 5 above were in conformance with the rules of the Michigan Board of Land Surveyors or by a Decree of a Court of Law, established, re-established, monumented, recovered, found as expressed below.

NOTE: Not more than 2 corners, all in the same town and range, may be recorded on this certificate.

Register of Deeds Stamp & File Number

	A	B	C	D	E	F	G	H	I	J	K	L	M
1													
2	6		5		4		3		2		1		
3													
4	7		8		9		10		11		12		
5													
6	18		17		16		15		14		13		
7													
8	19		20		21		22		23		24		
9													
10	30		29		28		27		26		25		
11													
12	31		32		33		34		35		36		
13													

A. Description of original monument and accessories and/or subsequent restoration:
G.L.O. Not Set

- L-4 P-273 1981 (Joiner)
- Part B Found "T" iron from old ties
- Part C Set Cast Iron Monument
 - 40" Catalpa W 25.49
 - 21" Catalpa NW 68.00
 - 22" Elm E 24.90
 - 29" Elm SE 55.02

Muskegon County Information
L-1301, P-604, 1984 (Lewandoski)
M-4: Found Cast Iron Monument
36" Catalpa West 25.20'
26" Catalpa N20°W 68.0'
T. Pole N25°E 68.70'
28" Basswood East 25.03'
10" Elm S40°E 41.15'

B. Description of corner evidence found and/or method applied in restoring or reestablishing corner:

- A-4 Found: Cast Iron Monument in Gravel
 - 40" Catalpa W 25.5'± (No Nail or Marker)
 - 28" Catalpa NW 68.0'± (No Nail or Marker)
 - 30" Elm E 24.9'± (No Nail or Marker)
 - 30" Elm SE 55.0'± (No Nail or Marker)

PA. 345 OTTAWA COUNTY

RECORD APPROVED 7/12/99


This position not established by original government surveyors. This location is accepted as the best available evidence of the position of the corner.

C. Description of monument for corner and accessories established to perpetuate locating the position of the corner:

- A-4 Cast Iron Monument in gravel (See Sketch)
 - Set Ottawa County Remon Tag & Nail in N side 30" Elm
 - Set Ottawa County Remon Tag & Nail in W side 30" Elm
 - Set Ottawa County Remon Tag & Nail in S side 40" Catalpa
 - Set Ottawa County Remon Tag & Nail in SW side 28" Catalpa

- AZ 94°35' 25.15'
- AZ 155°25' 55.09'
- AZ 264°30' 25.13'
- AZ 337°55' 67.07'

On fence rows ± E&W
Centerline gravel rd. (Squires Rd.) West 2.0'

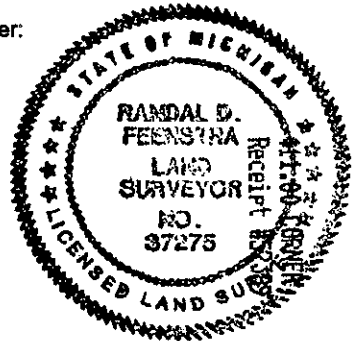

Signed by *Randal D. Feenstra*
Surveyor's Michigan License No. 37275

Date May 14, 1999

FEB 24 2000

SECTION

