

RF

FEB 24 2000

OTTAWA COUNTY REMONUMENTATION
LAND CORNER RECORDATION CERTIFICATE
Filing Requirement of Act 74, Mich. P.A. 1970

RECORDED
99 JUL 30 PM 12:26

SECTION

Doug L. ...
REGISTER OF DEEDS
OTTAWA COUNTY, MI

For corners in
Ottawa

Located In:	Corner Code #	
	Chester Twp.	A-10 W 1/4 Cor.
9N 13W		Sec. 30
T ___ R ___	___	___
T ___ R ___	___	___
T ___ R ___	___	___
T ___ R ___	___	___
S ___ T ___ R ___	___	___
S ___ T ___ R ___	___	___
S ___ T ___ R ___	___	___
S ___ T ___ R ___	___	___

Register of Deeds Stamp & File Number

1. Public Land Survey

2. Property Controlling in Section

3. Miscellaneous Property in Sec.

4. Lot No. _____, Recorded Plat _____

5. Private Claims _____

Randal D. Feenstra March 15 99

I, Randal D. Feenstra, in a field survey on March 15, 1999 do hereby state that under requirements of P.A. 74, Michigan P.A. of 1970, the corner points mentioned in lines 1 and 2 above were in conformance with regulations and rules therefore as required in the current manual of survey instructions of the United States Department of the Interior, Bureau of Land Management or by a decree of a Court of Law and for that the corner points mentioned in lines 3, 4 and 5 above were in conformance with the rules of the Michigan Board of Land Surveyors or by a Decree of a Court of Law; established, re-established, monumented, recovered, found as expressed below:

NOTE: Not more than 2 corners, all in the same town and range, may be recorded on this certificate.

	A	B	C	D	E	F	G	H	I	J	K	L	M
1													
2	6		5		4		3		2		1		
3													
4	7		8		9		10		11		12		
5													
6	18		17		16		15		14		13		
7													
8	19		20		21		22		23		24		
9													
10	30		29		28		27		26		25		
11													
12	31		32		33		34		35		36		
13													

A. Description of original monument and accessories and/or subsequent restoration:
G.L.O. Not Set

- L-6 P-113 1990 (Joiner)
- A-10 Cast Iron Monument
- 14" Twin Oak NW 35.31
- 16" Basswood W 38.59
- 11" Ash NE 40.83
- 28" Maple SE 50.23

Muskegon County Information
M-10 L-1301, P-599 1984 (Lewandoski)
12" Tw. Oak N53°W 35.40'
30" Basswood East 36.94'
32" Oak S33°E 50.20'
14" Basswood West 38.53'
12" Basswood N50°E 40.87'

B. Description of corner evidence found and/or method applied in restoring or reestablishing corner:

- A-10 Found: Broken Cast Iron Monument in Gravel
- Nail in 12" Ash AZ 51°21' 40.84'
 - Nail in 30" Maple AZ 147°15' 50.24'
 - Nail in 15" Twin Oak AZ 306°45' 35.21'


P.A. 345 OTTAWA COUNTY
PEER APPROVED 7/12/99
[Signature]

This position not established by original government surveyors. This location is accepted as the best available evidence of the position of the corner.

C. Description of monument for corner and accessories established to perpetuate locating the position of the corner:

- A-10 Broken Cast Iron Monument in gravel (See Sketch)
- Set Ottawa County Remon Tag & Nail in SE side 12" Ash AZ 51°21' 40.84'
 - Set Ottawa County Remon Tag & Nail in NE side 30" Maple AZ 147°15' 50.24'
 - Set Ottawa County Remon Tag & Nail in S side 14" Basswood AZ 272°40' 38.17'
 - Set Ottawa County Remon Tag & Nail in SW side Twin Oak AZ 306°45' 35.21'

On centerline N-S gravel Rd. (48th Ave.)

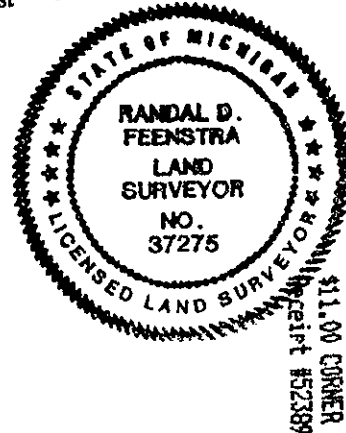

Signed by *Randal D. Feenstra*
Surveyor's Michigan License No. 37275

May 14, 1999
Date _____

PROPERTY &
RECORDS
FEB 24 2000
SECTION

