

SURVEY & REMONUMENTATION

JUN 28 1999

**OTTAWA COUNTY REMONUMENTATION
LAND CORNER RECORDATION CERTIFICATE
Filing Requirement of Act 74, Mich. P.A. 1970**

RECORDED

98 NOV 11 PM 1:26

SECTION

For corners in

Gary DeWitt
REGISTER OF DEEDS
OTTAWA COUNTY, MI

<u>OTTAWA</u> (County)	Located In:	Corner Code #
1. Public Land Survey	T <u>9N</u> R <u>13W</u>	<u>A-13 SW Sec 31</u>
	T <u> </u> R <u> </u>	<u>Chester Twp</u>
	T <u> </u> R <u> </u>	<u> </u>
	T <u> </u> R <u> </u>	<u> </u>
2. Property Controlling in Section	S <u> </u> T <u> </u> R <u> </u>	<u> </u>
	S <u> </u> T <u> </u> R <u> </u>	<u> </u>
3. Miscellaneous Property in Sec.	S <u> </u> T <u> </u> R <u> </u>	<u> </u>
	S <u> </u> T <u> </u> R <u> </u>	<u> </u>

Register of Deeds Stamp & File Number

4. Lot No. _____, Recorded Plat _____
5. Private Claims _____

I, Randal J. Vugteveen, in a field survey on October 12, 1998 do hereby state that under requirements of P.A. 74, Michigan P.A. of 1970, the corner points mentioned in lines 1 and 2 above were in conformance with regulations and rules therefore as required in the current manual of survey instructions of the United States Department of the Interior, Bureau of Land Management or by a decree of a Court of Law and /or that the corner points mentioned in lines 3, 4 and 5 above were in conformance with the rules of the Michigan Board of Land Surveyors or by a Decree of a Court of Law, established, re-established, monumented, recovered, found as expressed below.

NOTE: Not more than 2 corners, all in the same town and range, may be recorded on this certificate.

A	B	C	D	E	F	G	H	I	J	K	L	M
1												
2	6		5		4		3		2		1	
3												
4	7		8		9		10		11		12	
5												
6	18		17		16		15		14		13	
7												
8	19		20		21		22		23		24	
9												
10	30		29		28		27		26		25	
11												
12	31		32		33		34		35		36	
13												

A. Description of original monument and accessories and/or subsequent restoration:

A-13 set by Mullet April 7, 1837
Set township corner for Town 8 & 9 N, Range 13 & 14 W
20" sugar S63W 17 links
8" beech S43E 30 links

M-1 T8N, R14W Liber 2, Page 743
Englert Feb. 1975
Found 4" brass marker
SW 28" maple 87.00'
SE USGS B.M 40.49'
NW st. sign 38.70'

A-13 T9N, R13W Liber 6, Page 119
Joiner Oct. 1990
Found brass plug in conc.
P.K. in Tel. Pole SE 55.33'
20" maple SW 133.87'
Street sign NW 57.38'
PP NE 116.56'

B. Description of corner evidence found and/or method applied in restoring or reestablishing corner:

A-13 found brass marker in concrete in monument box

Found nail NW side power pole N40°E 116.58'
Found P.K. nail in SW side tel pole S48°E 55.63'
Found nail in E. side 24" maple S11°W 113.81'

set "X" cut in existing brass marker in concrete in monument box


Accepted Brass Marker in concrete as a careful and faithful perpetuation of the position of the original corner

PA. 345 OTTAWA COUNTY
PEER APPROVED 10/19/98
[Signature]

C. Description of monument for corner and accessories established to perpetuate locating the position of the corner:

A-13 Brass Marker in concrete in Monument Box

Ottawa County Remon tag and Nail NW side power pole N40°E 116.58'
Ottawa County remon tag and Nail SW side telephone pole S48°E 55.63'
Ottawa County remon tag and Nail NW side cut power pole/fence post S45°W 54.64'
Ottawa County remon tag and Nail E. side 24" maple S11°W 133.81'
CL "X" 2.8' south

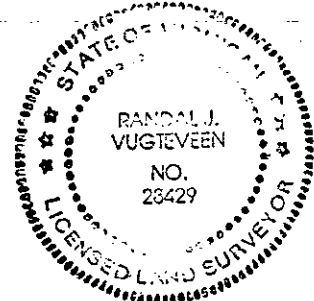

\$9.00 CORNER
Receipt #19293

Signed by *[Signature]*
Surveyor's Michigan License No. 28429

Date OCTOBER 19, 1998

28429
Receipt #19293