

SURVEY & REMONUMENTATION

DEC 16 1996

COMMISSION

**OTTAWA COUNTY REMONUMENTATION
LAND CORNER RECORDATION CERTIFICATE**
Filing Requirement of Act 74, Mich. P.A. 1970

For corners in
Ottawa
(County)

Located in:	Chester Twp. 9N 13W	Corner Code # B-5, S 1/4 cor.
1. Public Land Survey	T ___ R ___ T ___ R ___ T ___ R ___ T ___ R ___	Sec. <u>7</u>
2. Property Controlling in Section	S ___ T ___ R ___ S ___ T ___ R ___	
3. Miscellaneous Property in Sec.	S ___ T ___ R ___ S ___ T ___ R ___	

4. Lot No. _____, Recorded Plat _____
5. Private Claims _____

I, Randal D. Feenstra, in a field survey on March 25, 19 96 do hereby state that under requirements of P.A. 74, Michigan P.A. of 1970, the corner points mentioned in lines 1 and 2 above were in conformance with regulations and rules therefore as required in the current manual of survey instructions of the United States Department of the Interior, Bureau of Land Management or by a decree of a Court of Law and for that the corner points mentioned in lines 3, 4 and 5 above were in conformance with the rules of the Michigan Board of Land Surveyors or by a Decree of a Court of Law; established, re-established, monumented, recovered, found as expressed below:

NOTE: Not more than 2 corners, all in the same town and range, may be recorded on this certificate.

1	A	B	C	D	E	F	G	H	I	J	K	L	M
2		6		5		4		3		2		1	
3													
4		7		8		9		10		11		12	
5													
6		18		17		16		15		14		13	
7													
8		19		20		21		22		23		24	
9													
10		30		29		28		27		26		25	
11													
12		31		32		33		34		35		36	
13													

RECORDED

96 NOV 14 AM 11:20

Randy D. Feenstra
REGISTER OF DEEDS
OTTAWA COUNTY, MI

Register of Deeds Stamp & File Number

A. Description of original monument and accessories and/or subsequent restoration:

G.L.O. (1838)		L-4, P-210, (1981)
Rasselas Whitcomb		Cast Iron Monument
Post		28" Maple S 27.72'
8" Beech	S42°W 21 lks	12" Maple SW 29.73'
8" Beech	N74°E 21 lks	Telephone Pole NW 130.24'
		Tele. sign N 21.65'

P.A. 345 OTTAWA COUNTY
PEER APPROVED 9-16-96
R. D. Feenstra

B. Description of corner evidence found and/or method applied in restoring or reestablishing corner:


B-5 Cast Iron Monument in Gravel Road

Nail E side T. Pole	Az. 284°	130.18'
Tele. sign	N 21.5'	

Accepted as a careful and faithful perpetuation of the position of the original corner.

C. Description of monument for corner and accessories established to perpetuate locating the position of the corner:

B-5 Cast Iron Monument in Gravel Road	Az. 284°	130.57'
Ottawa County Remon Nail & Tag in S side P. Pole	Az. 179°	138.32'
Ottawa County Remon Nail & Tag in W side 6" Maple	Az. 85°	260.40'
Ottawa County Remon Nail & Tag in S side 18" Ash	Az. 264°	198.38'
Ottawa County Remon Nail & Tag in N side 24" Maple		
On CL E-W gravel road		

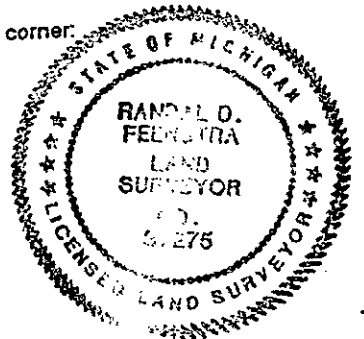

Signed by *Randal D. Feenstra*
Surveyor's Michigan License No. 37275

Date September 16, 1996