

**SURVEY & REMONUMENTATION**

APR 05 1996

**COMMISSION**

**OTTAWA COUNTY REMONUMENTATION  
LAND CORNER RECORDATION CERTIFICATE  
Filing Requirement of Act 74, Mich. P.A. 1970**

For corners in  
Ottawa

(County)	Located In:	Corner Code #
1. Public Land Survey	Chester Twp. T <u>9N</u> R <u>13W</u>	B-11, N 1/4 cor. Sec. <u>31</u>
2. Property Controlling in Section	S _____ T _____ R _____	_____
3. Miscellaneous Property in Sec.	S _____ T _____ R _____	_____

RECORDED

95 NOV 29 PM 1:37

*Phyllis Redman*  
REGISTER OF DEEDS  
OTTAWA COUNTY, MI

Register of Deeds Stamp & File Number

4. Lot No. \_\_\_\_\_, Recorded Plat \_\_\_\_\_  
5. Private Claims \_\_\_\_\_

	A	B	C	D	E	F	G	H	I	J	K	L	M
2	6	5	4	3	2	1							
3													
4	7	8	9	10	11	12							
5													
6	16	17	16	15	14	13							
7													
8	19	20	21	22	23	24							
9													
10	30	29	28	27	26	25							
11	●												
12	31	32	33	34	35	36							
13													

Randal D. Feenstra November 6 95

I, \_\_\_\_\_, in a field survey on \_\_\_\_\_, 19 \_\_\_\_\_, do hereby certify that under requirements of P.A. 74, Michigan P.A. of 1970, the corner points mentioned in lines 1 and 2 above were in conformance with regulations and rules therefore as required in the current manual of survey instructions of the United States Department of the Interior, Bureau of Land Management or by a decree of a Court of Law and/or that the corner points mentioned in lines 3, 4 and 5 above were in conformance with the rules of the Michigan Board of Land Surveyors or by a Decree of a Court of Law; established, re-established, monumented, re-monumented, recovered, found as expressed below:

**NOTE: Not more than 4 corners, all in the same town and range, may be recorded on this certificate.**

A. Description of original monument and accessories and/or subsequent restoration:

G.L.O. (1838)	L-5, P-6, (1982)		
Rassclus Whitcomb	C.I.M.		
15" Maple N43°W 4 lks.	3" Elm	NE	35.19'
5" Ironwood S57°E 16 lks	Fence Post	N	27.53'
	Steel Fence Post	SSE	38.42'
	Steel Fence Post	SW	45.30'

B. Description of corner evidence found and/or method applied in restoring or reestablishing corner:

Found: C.I.M. in box (top cracked off, no cover)  
Accepted as a careful and faithful perpetuation of the position of the original corner.

Dbl. headed Nail & Tag in S side 10:" stump NE 35.25'  
Pk and tag in E side Fence Post N 27.62'


PA. 345 OTTAWA COUNTY  
PEER APPROVED 11/20/95

*Randal D. Feenstra*  
*YDN*

C. Description of monument for corner and accessories established to perpetuate locating the position of the corner:

B-11 C.I.M. in box (top cracked off, no cover)			
Ottawa County Remon Nail & Tag in S side 10" Stump	39°	35.39'	
Ottawa County Remon Nail & Tag in W side 8" Maple	0°	58.22'	
Ottawa County Remon Nail & Tag in W side 10" Maple	253°	178.49'	
Ottawa County Remon. Nail & Tag in E side P. Pole	213°	134.63'	

On centerline Harding St, freeline to North

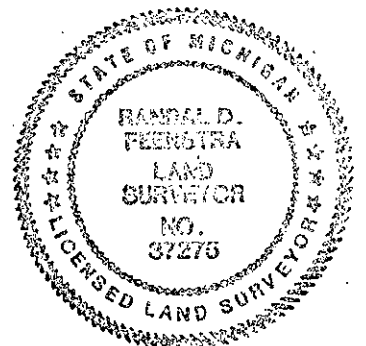

Signed by *Randal D. Feenstra*

Date November 6, 1995

Surveyor's Michigan License No. 37275