

SURVEY & REMONUMENTATION

APR 24 1995

OTTAWA COUNTY REMONUMENTATION LAND CORNER RECORDATION CERTIFICATE Filing Requirement of Act 74, Mich. P.A. 1970

RECORDED

94 DEC 15 AM 11:48

For corners in
Ottawa
COMMISSION

Robert B. Carlsson
REGISTER OF DEEDS
OTTAWA COUNTY, MI

(County)	Located In:	Corner Code #/
1. Public Land Survey	T <u>9N</u> R <u>13W</u>	C-4, E 1/4 Cor.
	T _____ R _____	Sec. 8
	T _____ R _____	Chester Twp.
	T _____ R _____	
2. Property Controlling in Section	S _____ T _____ R _____	
	S _____ T _____ R _____	
3. Miscellaneous Property in Sec.	S _____ T _____ R _____	
	S _____ T _____ R _____	

Register of Deeds Stamp & File Number

4. Lot No. _____, Recorded Plat _____
5. Private Claims _____

	A	B	C	D	E	F	G	H	I	J	K	L	M
2	6		5		4		3		2		1		
3													
4	7	•	8		9		10		11		12		
5													
6	18		17		16		15		14		13		
7													
8	19		20		21		22		23		24		
9													
10	30		29		28		27		26		25		
11													
12	31		32		33		34		35		36		
13													

Randal D. Feenstra December 8 94

I, _____, in a field survey on _____, 19 _____, do hereby certify that under requirements of P.A. 74, Michigan P.A. of 1970, the corner points mentioned in lines 1 and 2 above were in conformance with regulations and rules therefore as required in the current manual of survey instructions of the United States Department of the Interior, Bureau of Land Management or by a decree of a Court of Law and/or that the corner points mentioned in lines 3, 4 and 5 above were in conformance with the rules of the Michigan Board of Land Surveyors or by a Decree of a Court of Law; established, re-established, monumented, re-monumented, recovered, found as expressed below:

NOTE: Not more than 4 corners, all in the same town and range, may be recorded on this certificate.

A. Description of original monument and accessories and/or subsequent restoration:
 G.L.O. by Rasselas Whitcomb L-2, P-103, (1973) L-4, P-273 (1981)
 Sept. 17, 1838 STONE and 5/8" Rod C.I.M.
 POST Tw. Cherry NW 67.54 S end 18" Conc. Culv. W 26.54'
 8" Sugar N47 W 12 links 3" Tree NE 44.95 N end 18" Conc. Culv. NW 44.26'
 6" Beech S60 E 8 links 3" Tw. Tree SE 47.00

B. Description of corner evidence found and/or method applied in restoring or reestablishing corner:
 Found: C.I.M. in box and is accepted as a careful and faithful perpetuation of the position of the original corner.


"X" in S end 18" Conc. Culv. - W 26.58'
 "X" in N end 18" Conc. Culv. NW 43.79'

PA. 345 OTTAWA COUNTY
 PEER APPROVED 12/12/94

Robert D. Nedrow

C. Description of monument for corner and accessories established to perpetuate locating the position of the corner:

C-4 C.I.M. in box
 "X" in S end 18" Conc. Culv. N85 W 26.58'
 "X" in N end 18" Conc. Culv. N45 W 43.79'
 W edge steel post S30 E 64.07'
 On CL 40th Avenue

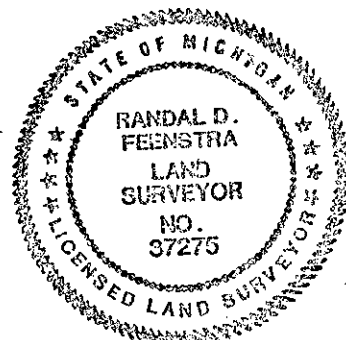

Randal D. Feenstra

Signed by Randal D. Feenstra Date December 8, 1994

Surveyor's Michigan License No. 37275