

SURVEY & REMONUMENTATION

OCT 24 1994

COMMISSION

**OTTAWA COUNTY REMONUMENTATION
LAND CORNER RECORDATION CERTIFICATE
Filing Requirement of Act 74, Mich. P.A. 1970**

RECORDED

94 OCT -7 PM 12:34

Daphne R. Kuhlman
REGISTER OF DEEDS
OTTAWA COUNTY, MI

For corners in

Ottawa (County)	Located In:	Corner Code #
1. Public Land Survey	T <u>9N</u> R <u>13W</u>	C-8, W 1/4 COR. SEC. 20, Chester
	T _____ R _____	_____
	T _____ R _____	_____
	T _____ R _____	_____
2. Property Controlling in Section	S _____ T _____ R _____	_____
	S _____ T _____ R _____	_____
3. Miscellaneous Property in Sec.	S _____ T _____ R _____	_____
	S _____ T _____ R _____	_____

Register of Deeds Stamp & File Number

4. Lot No. _____, Recorded Plat _____
5. Private Claims _____

	A	B	C	D	E	F	G	H	I	J	K	L	M
2	6	5	4	3	2	1							
3													
4	7	8	9	10	11	12							
5													
6	18	17	16	15	14	13							
7													
8	19	20	21	22	23	24							
9													
10	30	29	28	27	26	25							
11													
12	31	32	33	34	35	36							
13													

I, Randal D. Feenstra, in a field survey on April 28, 19 94, do hereby certify that under requirements of P.A. 74, Michigan P.A. of 1970, the corner points mentioned in lines 1 and 2 above were in conformance with regulations and rules therefore as required in the current manual of survey instructions of the United States Department of the Interior, Bureau of Land Management or by a decree of a Court of Law and/or that the corner points mentioned in lines 3, 4 and 5 above were in conformance with the rules of the Michigan Board of Land Surveyors or by a Decree of a Court of Law, established, re-established, monumented, re-monumented, recovered, found as expressed below:

NOTE: Not more than 4 corners, all in the same town and range, may be recorded on this certificate.

A. Description of original monument and accessories and/or subsequent restoration:

G.L.O. (1838)	Liber 4, Page 225 (1981)
18" Beech N25°E 9.2'	CAST IRON MONUMENT
12" Sugar Maple South 7.9'	Prop. Cor. East 23.30
POST	Fence Post East 24.70
Rasselas Whitcomb	Fence Post SE 147.20
	6" Apple WNW 26.45
	5" Ash NW 48.05


B. Description of corner evidence found and/or method applied in restoring or reestablishing corner:

Found: cast iron monument in monument box - accepted as a careful and faithful perpetuation of the position of the original corner.
Found Witnesses: _____
Property corner East 23.4'

P.A. 345 OTTAWA COUNTY
PEER APPROVED 8/23/94
Randal D. Feenstra

C. Description of monument for corner and accessories established to perpetuate locating the position of the corner:

C-8 Cast iron monument in monument box	
O.C. Remon. Nail & Tag in top of fence post	N90°W 35.46'
O.C. Remon. Nail & Tag in E side P.P.	S20°E 153.88'
O.C. Remon. Nail & Tag in N and 12" CSP	S85°E 28.16'
O.C. Remon. Nail & Tag in S end 12" CSP	S45°E 45.39'
On Cl. 40th Avenue, Fence Lines to E & W	

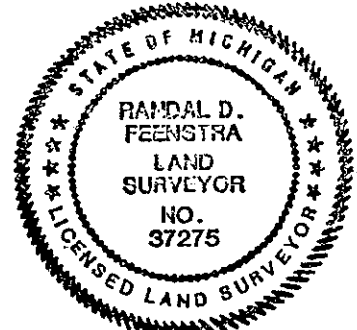

Signed by *Randal D. Feenstra* Date April 28, 1994

Surveyor's Michigan License No. 37275