

**SURVEY & REMONUMENTATION**

OCT 24 1994

COMMISSION

OTTAWA COUNTY REMONUMENTATION **RECORDED**  
**LAND CORNER RECORDATION CERTIFICATE**  
 Filing Requirement of Act 74, Mich. P.A. 1970 **OCT -7 PM 12:34**

For corners in

Ottawa

(County)

Located In:


Corner Code ##

- |                                    |   |    |   |     |                  |
|------------------------------------|---|----|---|-----|------------------|
| 1. Public Land Survey              | T | 9N | R | 13W | C-11, NW COR     |
|                                    | T |    | R |     | Sec. 32, Chester |
|                                    | T |    | R |     |                  |
|                                    | T |    | R |     |                  |
| 2. Property Controlling in Section | S |    | T | R   |                  |
|                                    | S |    | T | R   |                  |
| 3. Miscellaneous Property in Sec.  | S |    | T | R   |                  |
|                                    | S |    | T | R   |                  |
4. Lot No. \_\_\_\_\_, Recorded Plat \_\_\_\_\_
5. Private Claims \_\_\_\_\_

*Dorothy R. Caldwell*  
 REGISTER OF DEEDS  
 OTTAWA COUNTY, MI

Register of Deeds Stamp & File Number

I, Randal D. Feenstra in a field survey on May 9, 1994, do hereby certify that under requirements of P.A. 74, Michigan P.A. of 1970, the corner points mentioned in lines 1 and 2 above were in conformance with regulations and rules therelore as required in the current manual of survey instructions of the United States Department of the Interior, Bureau of Land Management or by a decree of a Court of Law and/or that the corner points mentioned in lines 3, 4 and 5 above were in conformance with the rules of the Michigan Board of Land Surveyors or by a Decree of a Court of Law; established, re-established, monumented, re-monumented, recovered, found as expressed below:

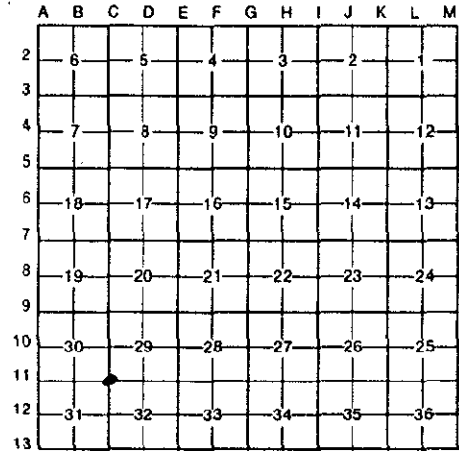

**NOTE: Not more than 4 corners, all in the same town and range, may be recorded on this certificate.**

A. Description of original monument and accessories and/or subsequent restoration:

G.L.O. (1838) Liber 6, Page 116 (1991)

14" Beech	N25°E 8.6'	CIM	
18" Beech	S02°E 23.8'	TP	NE 47.75
POST		Te1 Ped	NW 55.39
Rasselas Whitcomb		PP	WSW 142.68
		Street Sign	SE 52.47
		Bldg Corner	SW 118.55

B. Description of corner evidence found and/or method applied in restoring or reestablishing corner:

Found: Cast Iron Monument in Monument Box - accepted as a careful and faithful perpetuation of the position of the original corner.

Found Witnesses:


Nail in N side PP	WSW	142.63'
NE Cor. Bldg.	SW	118.61'
CL Street Sign Post	SE	52.51'

P.A. 345 OTTAWA COUNTY  
 PEER APPROVED 8/22/94

*Gordon R. Medwell*

C. Description of monument for corner and accessories established to perpetuate locating the position of the corner:

C-11 Cast Iron mon. in mon. box		
O.C. Remon. Nail & tag in N'side PP	N55°E	48.52'
O.C. Remon. Nail & tag in S side PP	S70°W	142.34'
"X" in N end 24" conc culv.	N60°W	47.72'
"X" in E end 24" conc culv.	S45°E	40.21'
1' S of CL "X" 40th and Harding Street		

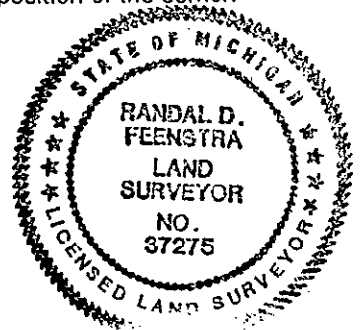

Signed by Randal D. Feenstra Date May 9, 1994

Surveyor's Michigan License No. 37275