SURVEY & REMONUMENTATION

OCT 24 1994

COMMISSION

RECORDED

94 OCT -7 PM 12: 34

REGISTER OF DEEDS
OTTAWA COUNTY, MI

OTTAWA COUNTY REMONUMENTATION
LAND CORNER RECORDATION CERTIFICATE

Filing Requirement of Act 74, Mich. P.A. 1970

For corners in Ottawa (County)

	Located In:	Corner Code ##
1. Public Land Survey	T 9N R 13W	C-12, W1/4 COR
	T ___ R ___	Sec. 32, Chester
	T ___ R ___	
	T ___ R ___	
2. Property Controlling	S ___ T ___ R ___	
in Section	S ___ T ___ R ___	
3. Miscellaneous	S ___ T ___ R ___	
Property in Sec.	S ___ T ___ R ___	

Register of Deeds Stamp & File Number

4. Lot No. _____, Recorded Plat _____
5. Private Claims _____

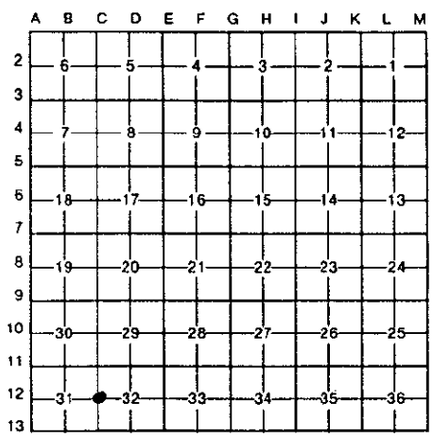

I, Randal D. Feenstra in a field survey on May 9, 19 94, do hereby certify that under requirements of P.A. 74, Michigan P.A. of 1970, the corner points mentioned in lines 1 and 2 above were in conformance with regulations and rules therefore as required in the current manual of survey instructions of the United States Department of the Interior, Bureau of Land Management or by a decree of a Court of Law and/or that the corner points mentioned in lines 3, 4 and 5 above were in conformance with the rules of the Michigan Board of Land Surveyors or by a Decree of a Court of Law; established, re-established, monumented, re-monumented, recovered, found as expressed below:

NOTE: Not more than 4 corners, all in the same town and range, may be recorded on this certificate.

A. Description of original monument and accessories and/or subsequent restoration:

G.L.O. (1838)

12" Elm N11°W 8.6'
14" Elm S74°W 4.0'
POST
Rasselas Whitcomb

Liber 3, Page 100 (1976)

"T" IRON
TP NW 35.88
TP ENE 92.40
Twin Elm SW 38.72

B. Description of corner evidence found and/or method applied in restoring or reestablishing corner:

Found Cast Iron Mon. in Mon. Box (0.8' below road) – accepted as a careful and perpetuation of the position of the original corner.

Found Witnesses:

None

P.A. 345 OTTAWA COUNTY
PEER APPROVED 8/22/94
Gordon D. Wellewald

C. Description of monument for corner and accessories established to perpetuate locating the position of the corner:

C-12 Cast Iron Mon. in Mon. Box
O.C. Remon. Nail & tag in NE side PP — N45°W 38.47'
O.C. Remon. Nail & tag in SE side 10" Box Elder — S70°W 59.03'
O.C. Remon. Nail & tag in S side PP — N70°E 94.52'
CL Street sign post — S45°E 38.70'
3' N and 2' E of CL "X" 40th Avenue and Sehler Street.

STATE OF MICHIGAN
RANDAL D. FEENSTRA
LAND SURVEYOR
NO. 37275
LICENSED LAND SURVEYOR

Signed by Randal D. Feenstra Date May 9, 1994

Surveyor's Michigan License No. 37275

FORM APPROVED BY MICHIGAN STATE BOARD OF LAND SURVEYORS, JAN. 28, 1971
REVISED MAY 14, 1975
REVISED JAN., 1983