

# SURVEY & REMONUMENTATION

APR 24 1995

## OTTAWA COUNTY REMONUMENTATION LAND CORNER RECORDATION CERTIFICATE Filing Requirement of Act 74, Mich. P.A. 1970

RECORDED

94 DEC 15 AM 11:47

COMMISSION  
For corners in  
Ottawa

*D. J. Robinson*  
REGISTER OF DEEDS  
OTTAWA COUNTY, MI

(County)	Located In:	Corner Code #
1. Public Land Survey	T 9N R 13W	E-3, NE Cor.
	T _____ R _____	Sec. 8
	T _____ R _____	Chester Twp.
	T _____ R _____	
2. Property Controlling in Section	S _____ T _____ R _____	
	S _____ T _____ R _____	
3. Miscellaneous Property in Sec.	S _____ T _____ R _____	
	S _____ T _____ R _____	
4. Lot No. _____, Recorded Plat _____		
5. Private Claims _____		

Register of Deeds Stamp & File Number

Randal D. Feenstra December 8 94

I, \_\_\_\_\_, in a field survey on \_\_\_\_\_, 19 \_\_\_\_\_, do hereby certify that under requirements of P.A. 74, Michigan P.A. of 1970, the corner points mentioned in lines 1 and 2 above were in conformance with regulations and rules therefore as required in the current manual of survey instructions of the United States Department of the Interior, Bureau of Land Management or by a decree of a Court of Law and/or that the corner points mentioned in lines 3, 4 and 5 above were in conformance with the rules of the Michigan Board of Land Surveyors or by a Decree of a Court of Law; established, re-established, monumented, re-monumented, recovered, found as expressed below:

	A	B	C	D	E	F	G	H	I	J	K	L	M
2	6		5		4		3		2		1		
3					●								
4	7		8		9		10		11		12		
5													
6	10		17		16		15		14		13		
7													
8	19		20		21		22		23		24		
9													
10	30		29		28		27		26		25		
11													
12	31		32		33		34		35		36		
13													

**NOTE: Not more than 4 corners, all in the same town and range, may be recorded on this certificate.**

A. Description of original monument and accessories and/or subsequent restoration:  
 G.L.O. by Russelas Whitcomb L-2,P-11(1972) L-2,P-69(1973) L-2,P-103 (1973) L-5,P-49 (1983)  
 Sept. 17, 1838 PINCHED PIPE 3/4" IRON 3/4" IRON C.I.M.  
 POST P.Pole SW 61.74 F. Post NE 50.36 Fence P. NE 50.36 P.Pole SW 62.21  
 11" Sugar S 67 E 14 links St. Sign SE 53.15 St. Sign SE 53.41 T.Pole NNW 117.94  
 9" Beech S71 W 17 links P.Pole SW 61.77 P.Pole SW 61.77 Nail in Guard Post  
 NNE 93.72


B. Description of corner evidence found and/or method applied in restoring or reestablishing corner:  
 Found C.I.M. in box and is accepted as a careful and faithful perpetuation of the position of the original corner.

Nail in Top of Guard Post NNE 93.82'  
 Nail in SE side P. Pole SW 62.39'  
 Nail in W side T. Pole NNW 117.80'

P.A. 345 OTTAWA COUNTY  
 PEER APPROVED 12/12/94  
*Randy P. Nedrow*

C. Description of monument for corner and accessories established to perpetuate locating the position of the corner:

E-3 C.I.M. in box  
 O.C. Remon. Nail & Tag in Top of Guard Post N20 E 93.69'  
 O.C. Remon. Nail & Tag in E side 5" Twin Birch N30 W 90.43'  
 O.C. Remon. Nail & Tag in SE side P. Pole S45 W 62.18'  
 "X" in E side 30" Conc. Culv. S35 E 55.60'  
 On CL 32nd Avenue and Truman Street

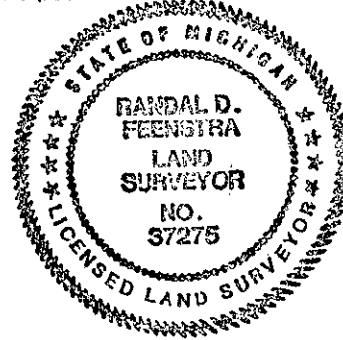

Signed by *Randal D. Feenstra*  
 Randal D. Feenstra

Date December 8, 1994

Surveyor's Michigan License No. 37275