

SURVEY & REMONUMENTATION

APR 24 1995

OTTAWA COUNTY REMONUMENTATION LAND CORNER RECORDATION CERTIFICATE

RECORDED

94 DEC 15 AM 11:48

COMMISSION

Filing Requirement of Act 74, Mich. P.A. 1970

Phyllis Kellerman
REGISTER OF DEEDS
OTTAWA COUNTY, MI

For corners in

Ottawa

(County)

Located In:

Corner Code #/

- | | | |
|---------------------------------------|--------------------------|------------------|
| 1. Public Land Survey | T <u>9N</u> R <u>13W</u> | E-4, E 1/4 Cor. |
| | T _____ R _____ | Section <u>8</u> |
| | T _____ R _____ | Chester Twp. |
| | T _____ R _____ | |
| 2. Property Controlling in Section | S _____ T _____ R _____ | |
| | S _____ T _____ R _____ | |
| 3. Miscellaneous Property in Sec. | S _____ T _____ R _____ | |
| | S _____ T _____ R _____ | |
| 4. Lot No. _____, Recorded Plat _____ | | |
| 5. Private Claims _____ | | |

Register of Deeds Stamp & File Number

	A	B	C	D	E	F	G	H	I	J	K	L	M
2	6	5	4	3	2	1							
3													
4	7	8	9	10	11	12							
5													
6	18	17	16	15	14	13							
7													
8	19	20	21	22	23	24							
9													
10	30	29	28	27	26	25							
11													
12	31	32	33	34	35	36							
13													

I, Randal D. Feenstra, in a field survey on December 8, 1994, do hereby certify that under requirements of P.A. 74, Michigan P.A. of 1970, the corner points mentioned in lines 1 and 2 above were in conformance with regulations and rules therefore as required in the current manual of survey instructions of the United States Department of the Interior, Bureau of Land Management or by a decree of a Court of Law and/or that the corner points mentioned in lines 3, 4 and 5 above were in conformance with the rules of the Michigan Board of Land Surveyors or by a Decree of a Court of Law; established, re-established, monumented, re-monumented, recovered, found as expressed below:

NOTE: Not more than 4 corners, all in the same town and range, may be recorded on this certificate.

A. Description of original monument and accessories and/or subsequent restoration:

G.L.O. by Rasselas Whitcomb Sept. 17, 1838	L-2, P-69 (1973) R.R. Spike	L-6, P-115 (1990) C.I.M.
POST	24" Oak SE 59.60'	P. Pole NW 43.52'
20" Blue Ash S83 W 40 links	20" Oak ESE 23.52'	26" Oak SSE 59.60'
10" Elm S25 E 19 links	36" Oak NE 102.29'	22" Oak ESE 23.52'
		36" Oak NNE 102.29'
	L-2, P-103 (1973) (Same as L-2, P-69)	

B. Description of corner evidence found and/or method applied in restoring or reestablishing corner:


Found: C.I.M. in box (No Cover) and is accepted as a careful and faithful perpetuation of the position of the original corner.

Nail in NE side P. Pole	NW	43.60
Nail in N side 22" Oak	ESE	23.52
Nail in W side 36" Oak	NNE	102.39

P.A. 345 OTTAWA COUNTY
PEER APPROVED 12/12/94
Verdoy D. Peterson

C. Description of monument for corner and accessories established to perpetuate locating the position of the corner:

E-4 C.I.M. in Box	
O.C. Remon. Nail & Tag in NW side P. Pole	N45 W 43.57'
O.C. Remon Nail & Tag in N side 22" Oak	S70 E 23.45'
O.C. Remon. Nail & Tag in W side 36" Oak	N15 E 102.42'
O.C. Remon Nail & Tag in W side 30" Oak	S20 E 59.66'
4' E of CL 32nd Avenue	

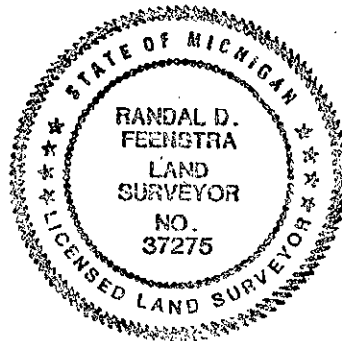

Signed by *Randal D. Feenstra*
Randal D. Feenstra

Date December 8, 1994

Surveyor's Michigan License No. 37275

FORM APPROVED BY MICHIGAN STATE BOARD OF LAND SURVEYORS, JAN. 28, 1971
REVISED MAY 14, 1975
REVISED JAN., 1983